IREDELL COUNTY HEALTH DEPARTMENT

Statesville Office (704) 878-5305 Mooresville Office (704) 660-3625 PERMIT # 21709 3

IMPROVEMENT PERMIT / AUTHORIZATION TO CONSTRUCT / OPERATION PERMIT / EXISTING SYSTEM

PIN # 4914748951

APPLICANT: Dennis Mahaffey APPLICANT ADDRESS: 535 McLarter Rd.

SITE ADDRESS: 164 Paddock Rd. PHONE: 336-984-3264 ALT. PHONE: N/A

SITE DIRECTIONS: Hwy 115 N TL Paddock Rd. Property on Right

SUBDIVISION: Prop Heirs of Emma Jane Mahaffey SECTION: N/A LOT # 6 LOT AREA: 6.7 acres DESIGN FLOW: Existing L.T.A.R.: Existing


Septic Tank	Existing	(gal)	STB		Date		☐ New System	☐ Repair	☐ Expansion	System Type: I II (III) IV V VI	
Pump Tank		(gal)	PT		Date		System Description:	Existing			
Pump Make			Model		Serial #		Repair System Description:				
# Nitrification Fields	Ex	# Lines	Ex	Linear Ft:	Ex		Maintenance Agreement Required:	☐ YES	☑ NO		
Trench Width	Ex	Max. Trench Bottom Depth	Ex	Gravel Depth	Ex			☐ GRAVITY	☐ PRESSURE		

☑ Residence No. Bedrooms Ex
☐ Business No. Persons Ex
☐ Other No. Employees
☐ Slab ☑ Crawl Space
☐ Basement w/plumbing ☐ Basement w/o plumbing


Water Supply: ☑ Private ☐ Public ☐ Community

Comments / Conditions: -Maintain a minimum of 5' between garage foundation & all components of septic tank system.

INITIAL SITE SKETCH

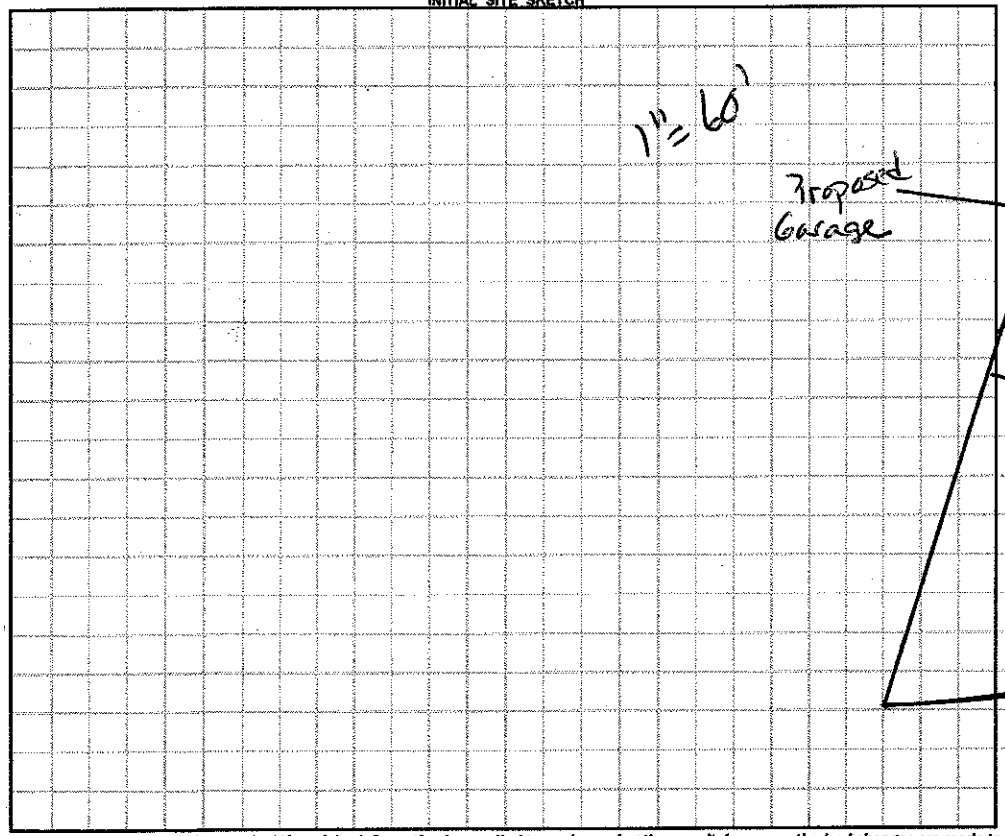

REPAIR AS-BUILT SKETCH

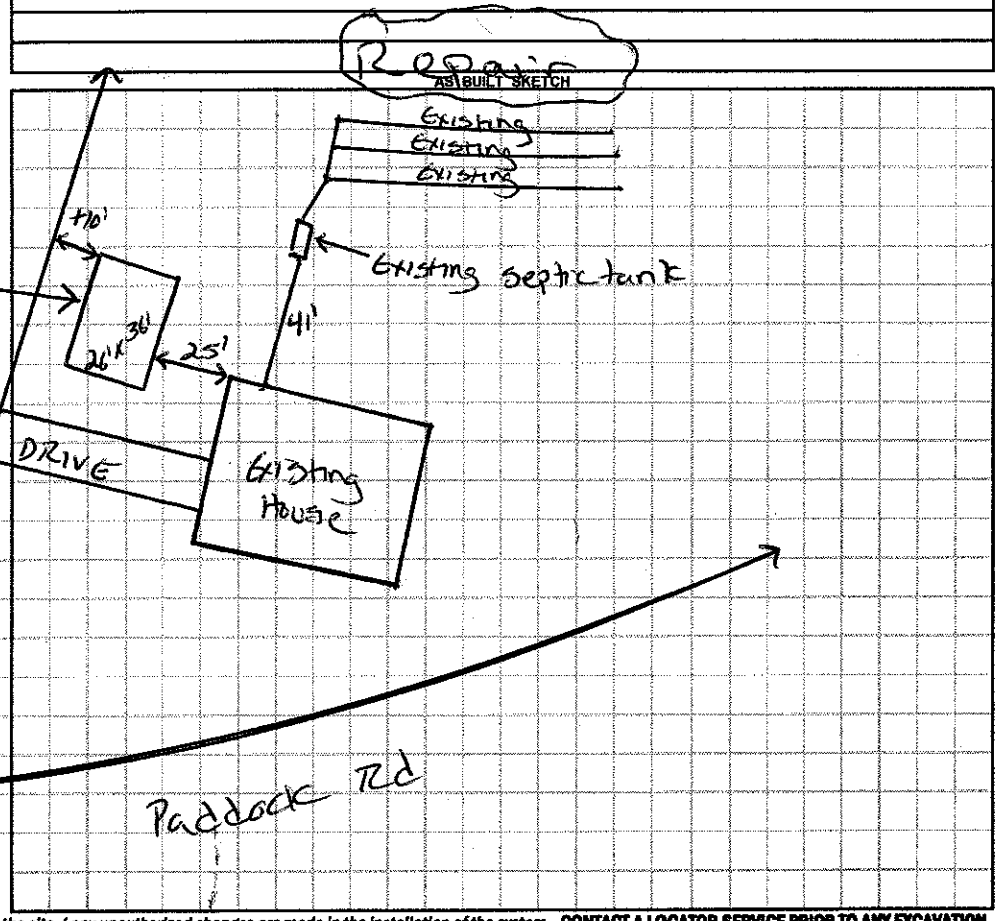

Permit can be suspended or revoked if any false information is supplied toward securing the permit / any unauthorized changes are made to the site / any unauthorized changes are made in the installation of the system. **CONTACT A LOCATOR SERVICE PRIOR TO ANY EXCAVATION**

☐ **IMPROVEMENT PERMIT** *with plat valid without expiration.* ☐ **IMPROVEMENT PERMIT** *with site plan valid for 60 mos.* ☐ **AUTHORIZATION TO CONSTRUCT** *valid for period equal to IMPROVEMENT PERMIT--not to exceed 60 mo.*

Owner / Applicant Signature: Dennis Mahaffey Date: 4-5-16 Installed by:

IMPROVEMENT PERMIT by: Date: OPERATION PERMIT by: Date:

AUTHORIZATION TO CONSTRUCT by: Date: Existing System Inspected by: Justin Henderson Date: 4-5-16

Health Dept. Copy - WHITE Applicant (Final Approval) - YELLOW Applicant (Conditional Approval) - PINK