IREDELL COUNTY HEALTH DEPARTMENT

Statesville Phone TR 3-7271 Mooresville Phone NO 3-1271

PERMIT TO INSTALL SEPTIC TANK

Permit NO. 29 Permit Date 8-1 1972

Owner Jerry Comer Address Rt 1 Union Grove

Installed By James Hartness Address Union Grove


Location of Property Out Hwy 115 - T.L. into Drive just before Comers Store near County line

Tank		Capacity		Length of Lines		Fixtures	
Block	( )	1000	(✓)	225'	(✓)	No. of Baths	(1)
Precast	(✓)	1250	( )	250'	( )	Dishwasher	( )
		1500	( )	Other		Garbage Grdr.	( )
		Other				Other	

NOTIFY HEALTH DEPARTMENT AT LEAST EIGHT HOURS BEFORE TANK IS TO BE INSPECTED.

Final Inspection 8-1 1972 Approved (✓) Disapproved ( )

Remarks Water from Hartness house on Hwy.

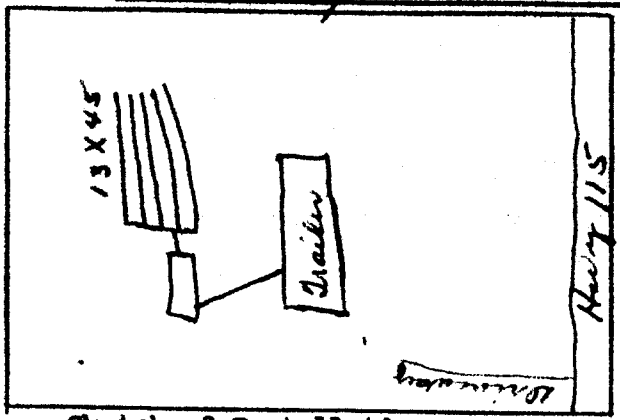

Sketch of Installation

E. A. Stevenson

Sanitarian