IREDELL COUNTY HEALTH DEPARTMENT

Statesville Phone TR 3-7271 Mooresville Phone NO 3-1271

PERMIT TO INSTALL SEPTIC TANK

Permit NO. 92 Permit Date Dec. 21 1970

Owner J. A. Dobson Address Rt. 5 - Statesville, N.C.

Installed By J.A. Dobson Address " " "


Location of Property 115 North Past Central School Then Right on Road # 1898. 1st House on Right

Tank		Capacity		Length of Lines		Fixtures	
Block	( )	1000	(✓)	225'	(✓)	No. of Baths	(1)
Precast	(✓)	1250	( )	250'	( )	Dishwasher	( )
		1500	( )	Other		Garbage Grdr.	( )
		Other				Other	

NOTIFY HEALTH DEPARTMENT AT LEAST EIGHT HOURS BEFORE TANK IS TO BE INSPECTED.

Final Inspection Dec 21 1970 Approved (✓) Disapproved ( )

Remarks

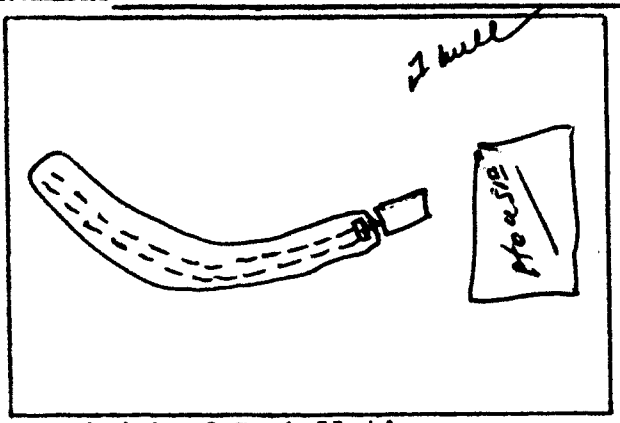

Sketch of Installation

Glenn Todd

Sanitarian