IREDELL COUNTY HEALTH DEPARTMENT

STATESVILLE 704-878-5305 (C1) MOORESVILLE 704-664-5281

BRADY FREEMAN (INSTALLER REGISTRATION)

IMPROVEMENT PERMIT / AUTHORIZATION TO CONSTRUCT / OPERATION PERMIT / EXISTING SYSTEM INSPECTION

(5)

PERMIT# 107936 PIN# 4820-05-3158 DATE 8-9-02

OWNER OR CONTRACTOR LARRY CALL PHONE Business 704-437-1242 Home 336-984-4230

ADDRESS 348 SOUTHER ROAD, N. WILKESBORO NC 28659

LOCATION NC 115 NORTH, TR DOBSON FARM ROAD, 0.1 MILE ON LEFT

SUBDIVISION _____ BLOCK / SECTION _____ LOT _____ LOT AREA 1.0 ACRE SITE CLASS PS DESIGN FLOW 360 L.T.A.R. 0.30 GPD/FT2

Septic Tank: 1000 Gallons; STB 620 Date 12-07-01
Pump Tank: _____ Gallons; PT _____ Date _____
Pump Make: _____ Model _____ Serial No _____
Nitrification Field: No Fields 1 Square Feet 1200 Linear Feet 400
No Lines FOUR Trench Width 36" Max Trench Bottom Depth 36 Gravel Depth 12"

✓ New System Repair System Type I II III IV V
System Description CONVENTIONAL, GRAVITY
Repair System Description CONVENTIONAL, GRAVITY
Maintenance Agreement Required: Yes ✓ No
Slab ✓ Crawl Space Basement w/plumbing Basement wo/plumbing

✓ House/Mod Home No Bedrooms 3
✓ Mobile Home No Bathrooms 2
Business No Employees
Other


Water Supply: ☐ Individual ☑ Public ☐ Community

Comments:/Conditions:

SCALE: 1" = 50'

Comments Conditions SEPTIC TANK WITH MARKER INSTALLED USING "ZABEL" FILTER

INITIAL SITE SKETCH

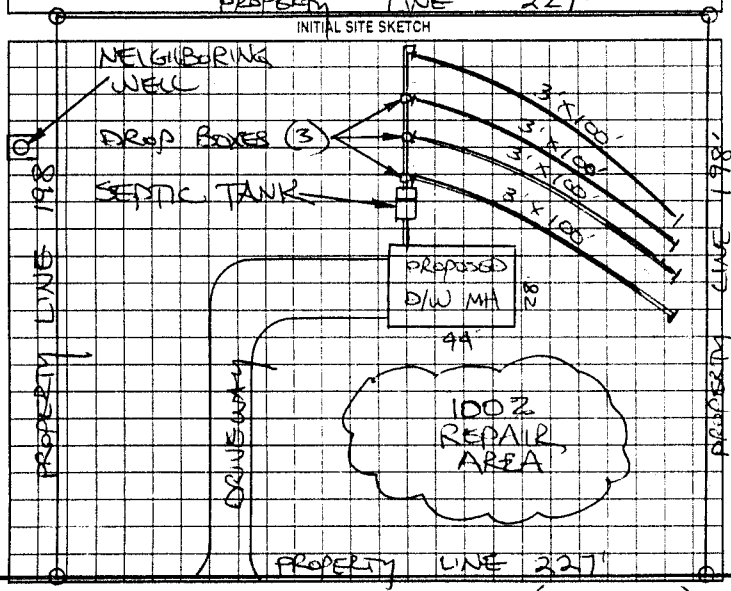

AS BUILT SKETCH

SYSTEM INSTALLED ACCORDING TO INITIAL SITE SKETCH

Permit can be suspended or revoked if any false information is supplied toward securing the permit or unauthorized changes are made to the site, any unauthorized changes are made in the installation of the system. Improvement Permit with plat valid without expiration. Improvement Permit with site plan valid for sixty months. Authorization to Construct is valid for a period equal to that of Improvement Permit – not to exceed sixty months.

LOT 5 DOBSON FARM ROAD SEP 1998

Signed: + Larry Wayne Call date 8-9-02 Installed by BRENT GRIT

Improvement Permit by: STEVE HEDRICK date 8-9-02 Operation Permit by STEVE HEDRICK date 8-16-02

Authorization to Construct by: STEVE HEDRICK date 8-9-02 Existing System Inspection by _____ date _____

HEALTH DEPT COPY WHITE OWNER COPY (FINAL) YELLOW OWNER COPY (INITIAL) PINK