IREDELL COUNTY HEALTH DEPARTMENT

Statesville Office (704) 878-5305 Mooresville Office (704) 660-3625 PERMIT # 20247

IMPROVEMENT PERMIT / AUTHORIZATION TO CONSTRUCT / OPERATION PERMIT / EXISTING SYSTEM

PIN # 4820055465

APPLICANT: Corbey Blankenship APPLICANT ADDRESS: 120 Purple Martin Ln Statesville NC 28625

SITE ADDRESS: 4486 Wilkesboro Hwy Statesville NC 28625 PHONE: 704-682-0256 ALT. PHONE: N/A

SITE DIRECTIONS: 115 N T/R Purple Martin Ln Stay right follow drive


SUBDIVISION: N/A SECTION: N/A LOT # N/A LOT AREA: 7.610 DESIGN FLOW: 240 L.T.A.R.: .25

Septic Tank	1000 (gal)	STB	1012	Date	4-29-14	[X] New System	[ ] Repair	[ ] Expansion	System Type: I II (III) IV V VI	[X] Residence	No. Bedrooms 2
Pump Tank	N/A (gal)	PT	N/A	Date	N/A	System Description:	25% Reduction			[ ] Business	No. Persons 4
Pump Make	N/A	Model	Pohlak	Serial #	PL-68	Repair System Description:	25% Reduction			[ ] Other	No. Employees
# Nitrification Fields	1	# Lines	2	Linear Ft:	240	Maintenance Agreement Required:	[ ] YES	[X] NO		[ ] Slab	[X] Crawl Space
Trench Width	36"	Max. Trench Bottom Depth	24"	Gravel Depth	N/A		[X] GRAVITY	[ ] PRESSURE		[ ] Basement w/plumbing	[ ] Basement w/o plumbing


Water Supply: [ ] Private [X] Public [ ] Community

Comments / Conditions: Install 25% reduction on contour with serial distribution.

INITIAL SITE SKETCH

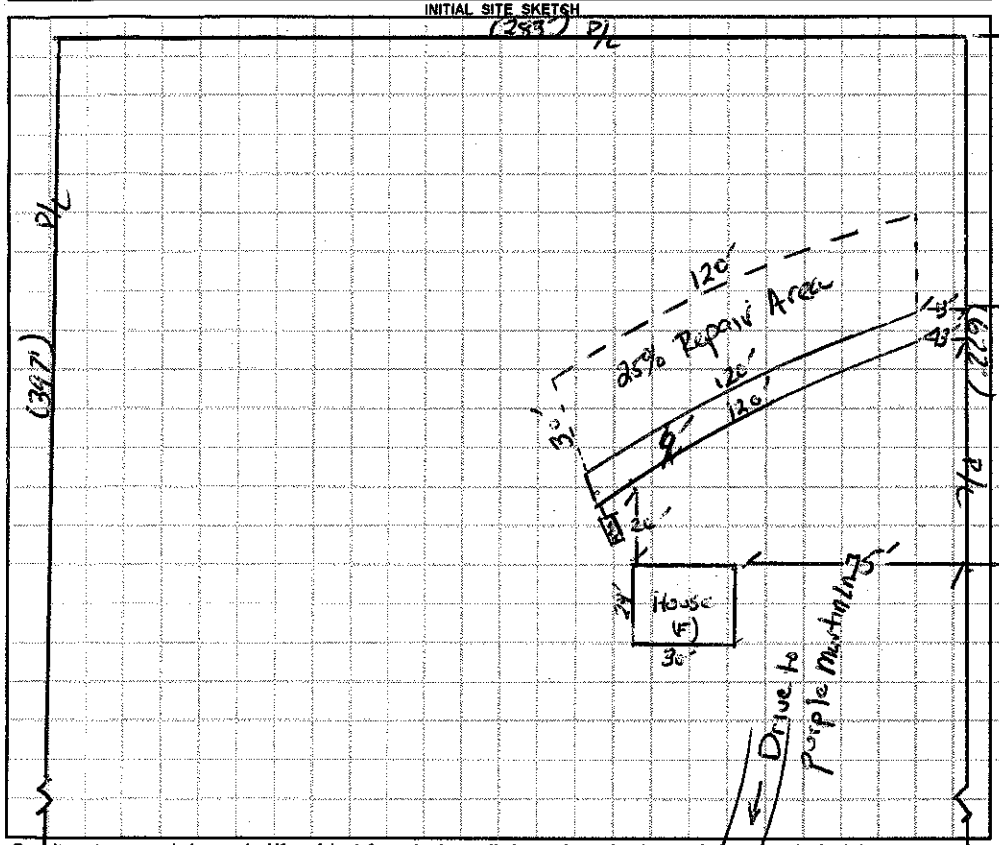

AS BUILT SKETCH

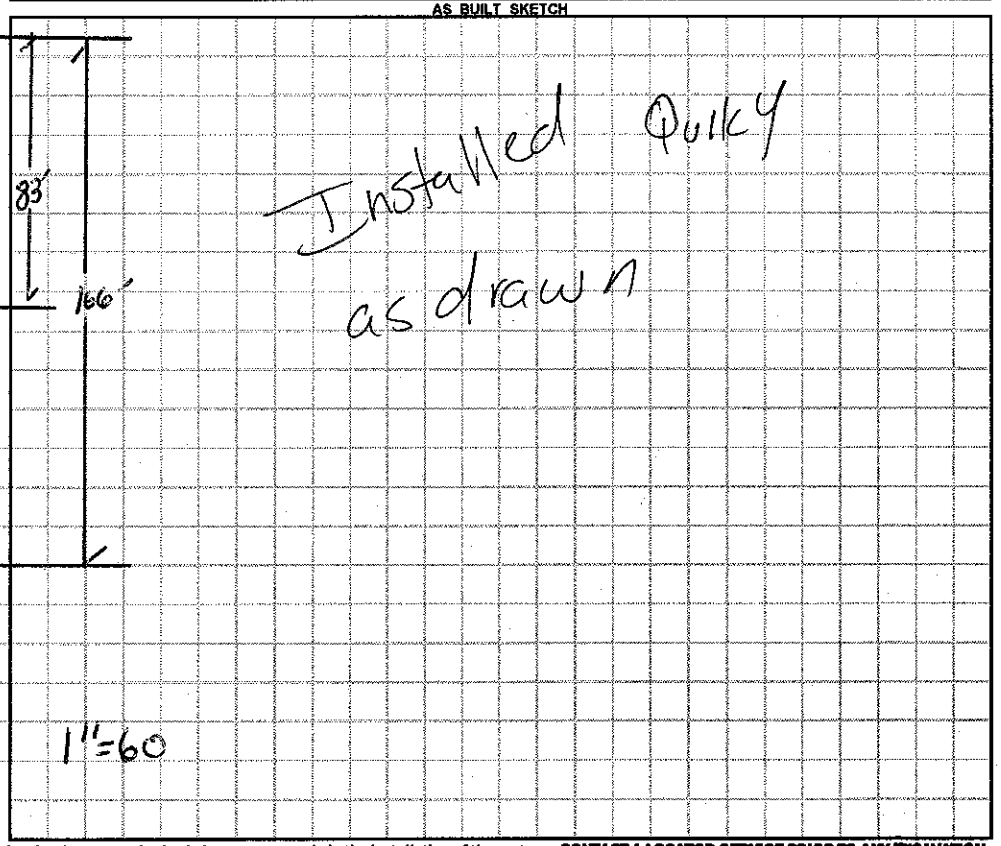

Permit can be suspended or revoked if any false information is supplied toward securing the permit / any unauthorized changes are made to the site / any unauthorized changes are made in the installation of the system. **CONTACT A LOCATOR SERVICE PRIOR TO ANY EXCAVATION**

[ ] **IMPROVEMENT PERMIT** *with plat valid without expiration.* [X] **IMPROVEMENT PERMIT** *with site plan valid for 60 mos.* [X] **AUTHORIZATION TO CONSTRUCT** *valid for period equal to IMPROVEMENT PERMIT--not to exceed 60 mo.*

Owner / Applicant Signature: Corbey Blankenship Date: 04-30-2014 Installed by: Shannon Henderson

IMPROVEMENT PERMIT by: Date: 04/21/14 OPERATION PERMIT by: Date: 06/16/14

AUTHORIZATION TO CONSTRUCT by: Date: 04/21/14 Existing System Inspected by: Date:

Health Dept. Copy - WHITE Applicant (Final Approval) - YELLOW Applicant (Conditional Approval) - PINK