IREDELL COUNTY HEALTH DEPARTMENT

IMPROVEMENT PERMIT / CERTIFICATE OF COMPLETION / OPERATION PERMIT / EXISTING SYSTEM INSPECTION

STATESVILLE 704-878-5305 MOORESVILLE 704-664-5281

PROPERTY DESCRIPTION NO. 69356
OWNER OR CONTRACTOR Burgess Hamm DATE 9-25-97
ADDRESS (151 Cross Country Rd) TAX MAP NO. 4820 0827780
LOCATION (Statesville, N.C.) PHONE: Business ______ Home 876 2751
SUBDIVISION ______ BLOCK / SECTION ______ LOT ______ 115N before Centeral VFD TL Cross Country 1/8mi Left Watershed: ☐ Yes ☐ No

Septic Tank: 1000 Gallons; STB 1012 Date 7-22-97
Pump Tank: ______ Gallons; PT ______ Date ______
Pump Make: ______ Model ______ Serial No. ______
Nitrification Field: No Fields 1 Square Feet 810 Linear Feet 270
No Lines 2 Trench Width 3'' Max Trench Bottom Depth 36'' Gravel Depth 12''

LOT AREA 9.8acres SITE CLASS. PS DESIGN FLOW 240 L.T.A.R. .3
☒ New System ☐ Repair System Type: I, II, III, IV, V, VI
System Description: Conv. Gravity
Repair System Description: " "
Maintenance Agreement Required: ☐ Yes ☒ No
☐ Slab ☐ Crawl Space ☐ Basement w/plumbing ☐ Basement wo/plumbing


☐ House/Mod. Home ☒ Mobile Home ☐ Business ☐ Other ______
No. Bedrooms 2 No. Bathrooms 2 No. Employees ______

Water Supply: ☒ Individual ☐ Community ☐ Public
Well Next door

Comments:

Comments:

INITIAL SITE SKETCH

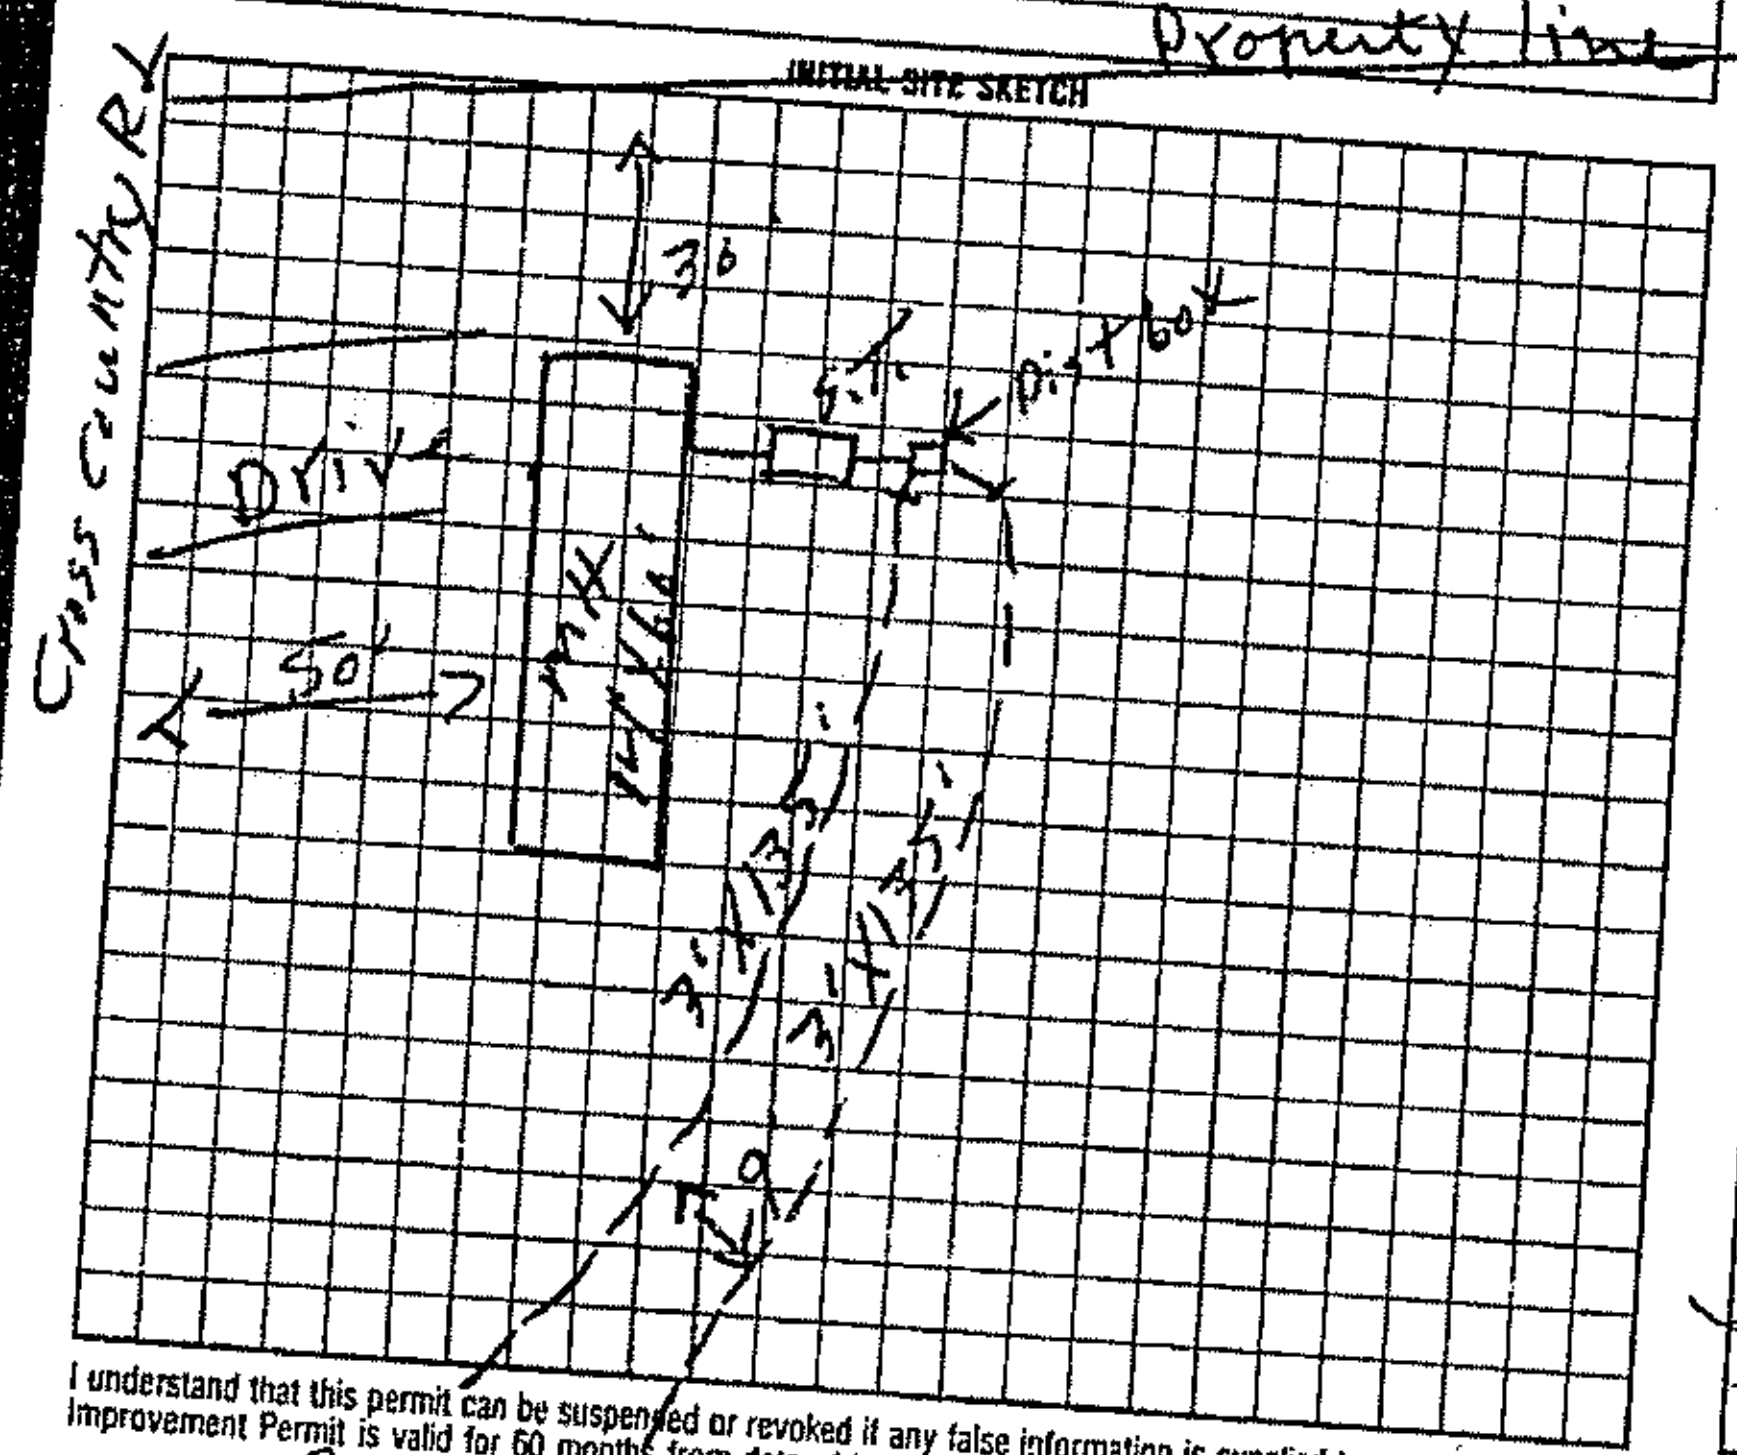

AS BUILT SKETCH

Same as initial sketch

I understand that this permit can be suspended or revoked if any false information is supplied toward securing the permit/any unauthorized changes are made to the site/any unauthorized changes are made in the installation of the system. Improvement Permit is valid for 60 months from date of issuance.

Signed: X Burgess Hamm

Improvement Permit by: F. C. Moore date 9-25-97
Authorization to cont.
Existing System Inspection By: F. C. Moore date 9-25-97

HEALTH DEPT. COPY: WHITE INSPECTION COPY (FINAL): GREEN OWNER COPY (FINAL): YELLOW

Installed by: Kenny Matison
Certificate of Completion by: ______
Operation Permit by: F. C. Moore date ______
INSPECTION COPY (INITIAL): PINK OWNER COPY (INITIAL): GOLD date 9-30-97

Authorization to cont. Expires 60 mos from issue