IREDELL COUNTY HEALTH DEPARTMENT - *ENVIRONMENTAL HEALTH* ☒ STATESVILLE OFFICE 704-878-5305 ☐ MOORESVILLE OFFICE 704-664-5281

IMPROVEMENT PERMIT / AUTHORIZATION TO CONSTRUCT / OPERATION PERMIT / EXISTING SYSTEM INSPECTION

PERMIT # 171782 PIN # 4820109911 DATE 4-25-12

OWNER Clayton, Daniel Ray APPLICANT: Clayton PHONE: Home/Cell # 704-239-3693 Business #

SITE ADDRESS Mohler Ln. OWNER / APPLICANT ADDRESS Mohler Lane

SITE DIRECTIONS 115N to (R) on Wilson Farm, (L) on Hicks, (L) on Mohler at end.

SUBDIVISION n/a BLOCK / SECTION n/a LOT # LOT AREA 2.28 Acres DESIGN FLOW 360 L.T.A.R. .3

Septic Tank 1000 Gallons: STB 1012 Date 2-28-12 ☒ New System ☐ Repair ☐ Expansion System Type I II (III) IV V VI

Pump Tank Gallons: P T Date System Description: 25% Reduction Gravity

Pump Make Model Serial # Repair System Description: 25% Reduction Gravity

No. Nitrification Fields: 1 No. Lines 3 Linear Feet 300 Maintenance Agreement Required ☐ YES ☒ NO


Trench Width 36" Max. Trench Bottom Depth 36" Gravel Depth n/a ☒ GRAVITY ☐ PRESSURE

☒ Residence No. Bedrooms 3 ☐ Business No. Persons ☐ Other No. Employees ☐ Slab ☒ Crawl Space ☐ Basement w/plumbing ☐ Basement w/o plumbing


Water Supply: ☒ Private ☐ Public ☐ Community

Comments / Conditions

INITIAL SITE SKETCH

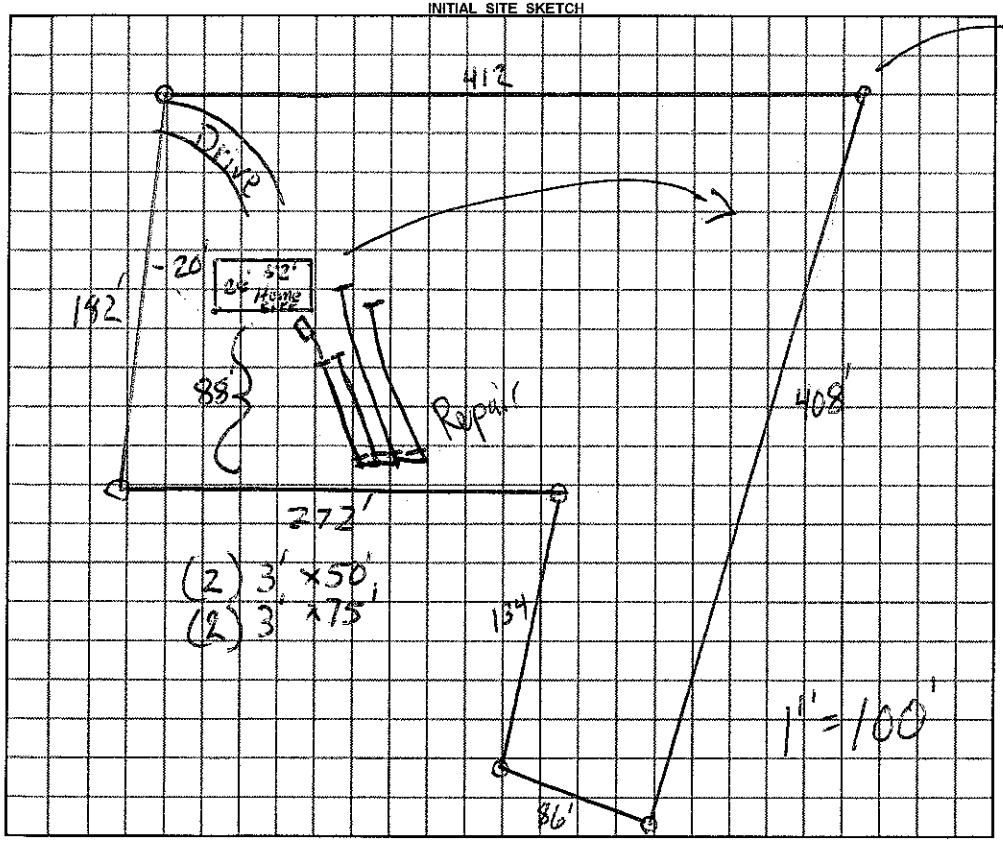

AS BUILT SKETCH

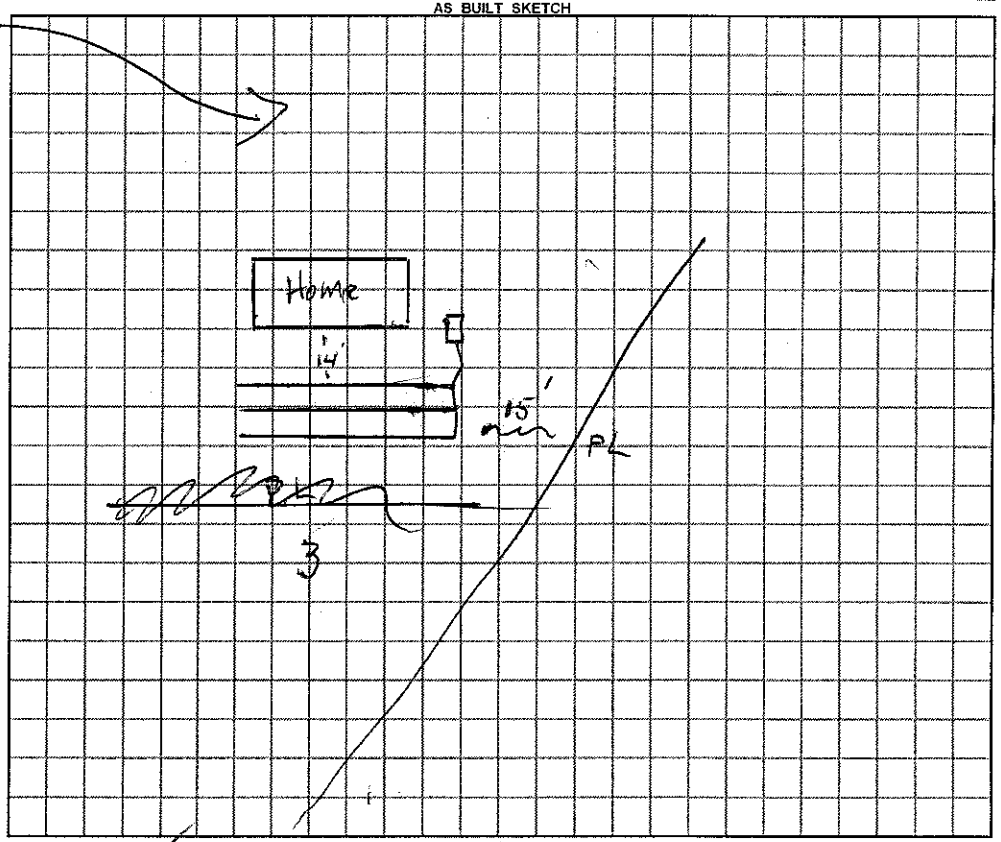

Permit can be suspended or revoked if any false information is supplied toward securing the permit / any unauthorized changes are made to the site / any unauthorized changes are made in the installation of the system.

☐ ***IMPROVEMENT PERMIT*** with plat valid without expiration ☒ ***IMPROVEMENT PERMIT*** with plat valid without expiration. site plan valid 60 mo. ☒ ***AUTHORIZATION TO CONSTRUCT*** valid for period equal to IMPROVEMENT PERMIT–not to exceed 60 mo.

Owner / Applicant Signature: Daniel Ray Clayton Date 4-25-12 Installed by: Groundbreakers

IMPROVEMENT PERMIT by: James Stevens REHS Date 4-25-12 OPERATION PERMIT by: James REHS Date 5-11-12

AUTHORIZATION TO CONSTRUCT by: James REHS Date 4-25-12 Existing System Inspected by: REHS Date

YOU SHOULD CONTACT A LOCATOR SERVICE PRIOR TO ANY EXCAVATION

White Copy – Environmental Health YELLOW COPY (Final) Owner / Applicant PINK COPY (Initial) Owner / Applicant