# IREDELL COUNTY HEALTH DEPARTMENT

STATESVILLE 704-878-5305 MOORESVILLE 704-664-5281

## IMPROVEMENT PERMIT / AUTHORIZATION TO CONSTRUCT / OPERATION PERMIT / EXISTING SYSTEM INSPECTION

PERMIT# REPAIR PIN# 4820-18-4743 4689 DATE 8-1-03

OWNER OR CONTRACTOR JAMES FOSTER PHONE: Business 704-872-8240 Home

ADDRESS 183 BOSTIAN LAKE, STATESVILLE, NC 28677

LOCATION NC 115 NORTH, ON LEFT ACROSS FROM CENTRAL SCHOOL FIRE DEPT. AT BOX # 4639

SUBDIVISION BLOCK / SECTION LOT LOT AREA 13.78 ACRES SITE CLASS. PS DESIGN FLOW 360 L.T.A.R. EXISTING

Septic Tank: EXISTING Gallons; STB Date

Pump Tank: Gallons; PT Date

Pump Make: Model Serial No.

Nitrification Field: No Fields 1 Square Feet 450 Linear Feet 150

No Lines THREE Trench Width 36" Max Trench Bottom Depth 36" Gravel Depth 18"

☒ New System ☑ Repair System Type: I, II, III, IV, V, VI

System Description: CONVENTIONAL, GRAVITY

Repair System Description: CONVENTIONAL, GRAVITY

Maintenance Agreement Required: ☐ Yes ☑ No

☑ House/Mod. Home No. Bedrooms 3

☐ Mobile Home No. Bathrooms 1

☐ Business No. Employees

☐ Other


☐ Slab ☑ Crawl Space ☐ Basement w/plumbing ☐ Basement wo/plumbing

Water Supply: ☑ Individual ☑ Public ☐ Community


Comments:/Conditions: (1) INSTALL FOUR NEW DROP BOXES AS SHOWN FEEDING BOTH NEW & OLD DRAINLINES (2) INSTALL LINES ON CONTOUR USING 18" STONE (3) THIS PERMIT SERVES AS "NOTICE OF VIOLATION," TO BE REPAIRED BY 9-1-03

Comments:/Conditions:

INITIAL SITE SKETCH

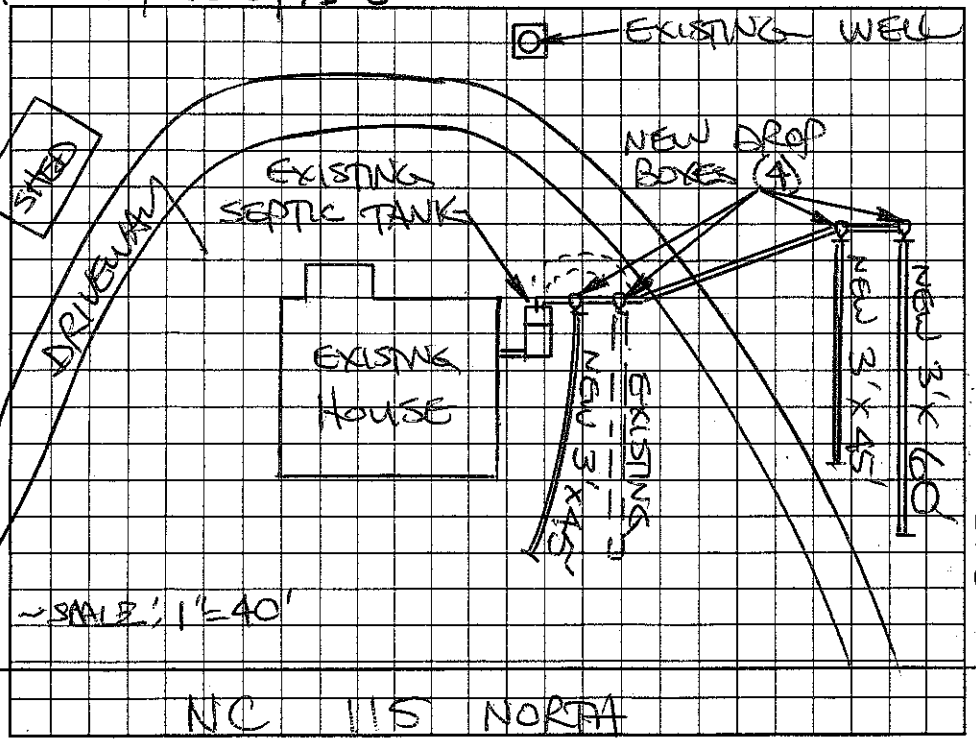


AS BUILT SKETCH

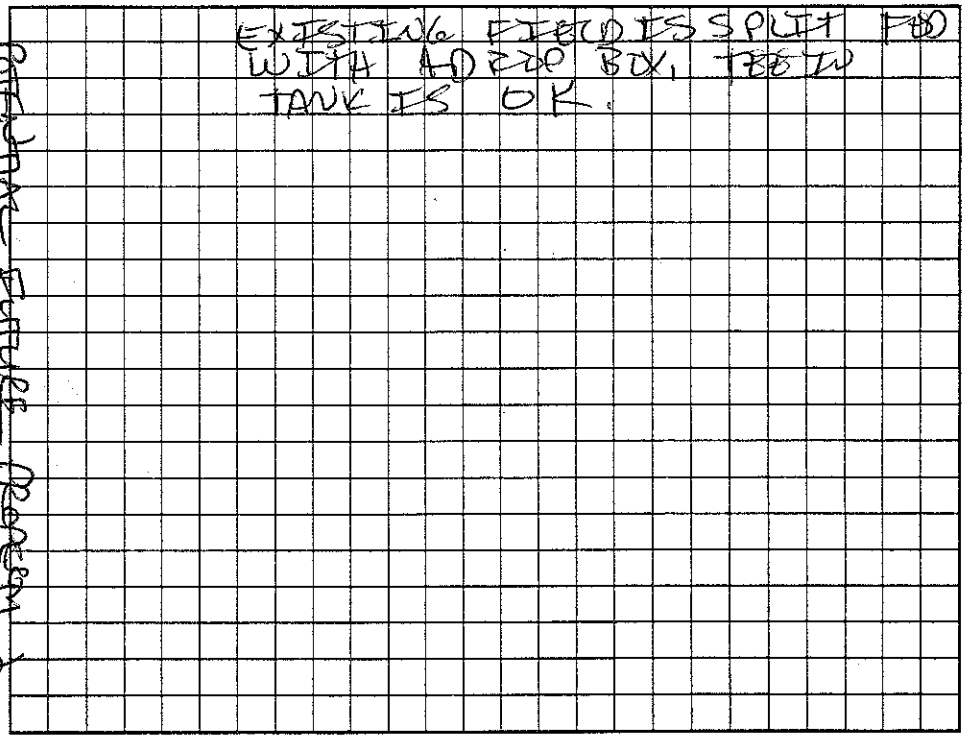


Permit can be suspended or revoked if any false information is supplied toward securing the permit/any unauthorized changes are made to the site/any unauthorized changes are made in the installation of the system. Improvement Permit with plat valid without expiration. Improvement Permit with site plan valid for sixty months. Authorization to Construct is valid for a period equal to that of Improvement Permit – not to exceed sixty months.

Signed: date 8-1-03 Installed by: J. RODELL BACKHOE

Improvement Permit by: STEVE HEDRICK date 8-1-03 Operation Permit by: RS date 9-2-03

Authorization to Construct by: STEVE HEDRICK date 8-1-03 Existing System Inspection by: date

HEALTH DEPT. COPY: WHITE OWNER COPY (FINAL): YELLOW OWNER COPY (INITIAL): PINK