IREDELL COUNTY HEALTH DEPARTMENT

STATESVILLE 704-878-5305 MOORESVILLE 704-664-5281

IMPROVEMENT PERMIT / AUTHORIZATION TO CONSTRUCT / OPERATION PERMIT / EXISTING SYSTEM INSPECTION

PERMIT# 92690 PIN# 4870280349 DATE 11/17/00

OWNER OR CONTRACTOR TIMOTHY FOX PHONE: Business Home 782-1364

ADDRESS PO BOX 383 TROUTMAN NC 28166

LOCATION HWY 115N - ON LT JUST PAST CENTRAL FIRE DEPT.

SUBDIVISION — BLOCK / SECTION — LOT — LOT AREA ~5 AC SITE CLASS. RS DESIGN FLOW 360GPD L.T.A.R. .30DW/RT2

Septic Tank: 1000 Gallons: STB 1007 Date 8-7-01
Pump Tank: Gallons: PT Date
Pump Make: Model Serial No
Nitrification Field: No Fields 1 Square Feet 900 Linear Feet 300
No Lines 5@60' Trench Width 36" Max Trench Bottom Depth 36"

☑ New System ☐ Repair System Type: I, II, (III), IV, V, VI
System Description: GRAVITY 25% REDUCTION
Repair System Description: SAME
Maintenance Agreement Required: ☐ Yes ☑ No
Gravel Depth N/A ☐ Slab ☑ Crawl Space ☑ Basement w/plumbing ☐ Basement wo/plumbing


☑ House/Mod. Home No. Bedrooms 3
☐ Mobile Home No. Bathrooms 2½
☐ Business No. Employees
☐ Other

Water Supply: ☑ Individual ☐ Public ☐ Community


Comments/Conditions:

Comments/Conditions: ① SEPTIC TANK WITH MARKER INSTALLED USING "POLYLOK" FILTER ② SYSTEM INSTALLED USING FIFTY (50) "BIODIFFUSER" CHAMBERS

INITIAL SITE SKETCH 1" = 100'

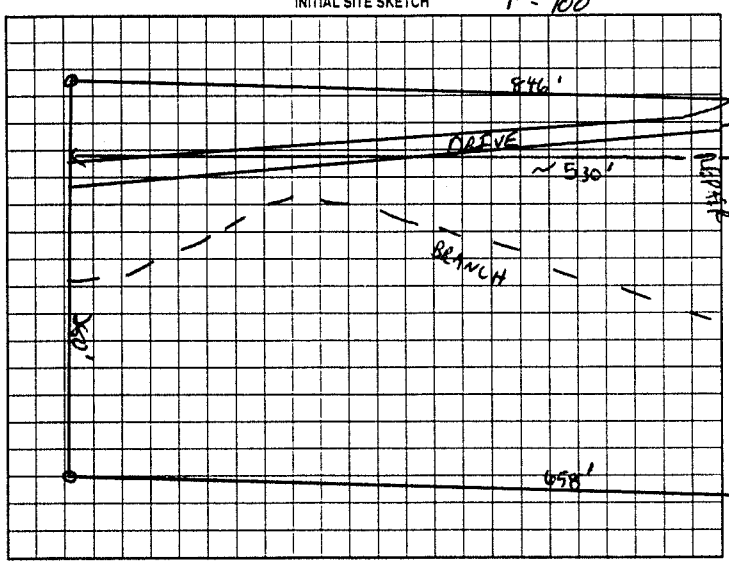

AS BUILT SKETCH

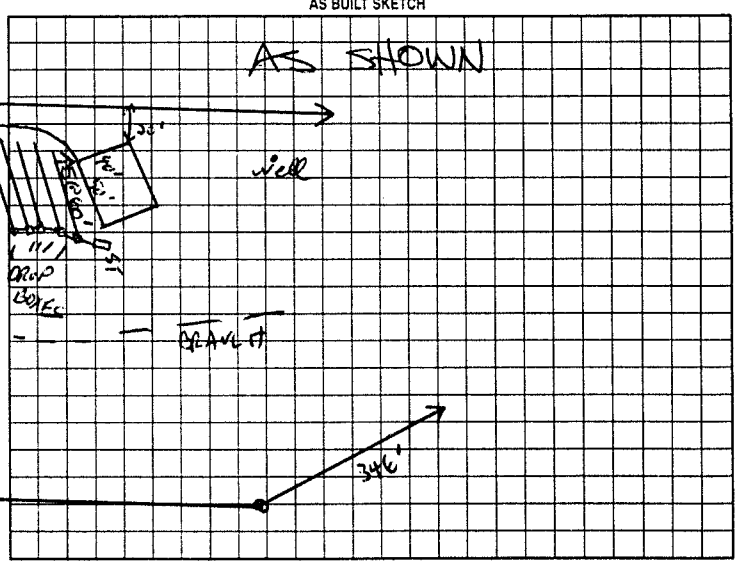

Permit can be suspended or revoked if any false information is supplied toward securing the permit/any unauthorized changes are made to the site/any unauthorized changes are made in the installation of the system. Improvement Permit with plat valid without expiration. Improvement Permit with site plan valid for sixty months. Authorization to Construct is valid for a period equal to that of Improvement Permit – not to exceed sixty months.

Signed: C. By Tom RS date 11/17/00 Installed by: JAMES BLANSETT

Improvement Permit by: C. By Tom RS date 11/17/00 Operation Permit by: STEVE HEDRICK date 9-17-01

Authorization to Construct by: C By Tom RS date 11/17/00 Existing System Inspection by: date

HEALTH DEPT COPY: WHITE OWNER COPY (FINAL): YELLOW OWNER COPY (INITIAL): PINK