IREDELL COUNTY HEALTH DEPARTMENT

STATESVILLE 704-878-5305 MOORESVILLE 704-664-5281

IMPROVEMENT PERMIT / AUTHORIZATION TO CONSTRUCT / OPERATION PERMIT / EXISTING SYSTEM INSPECTION

PERMIT# 088791 PIN# 4820 31 8528 DATE 4-27-00

OWNER OR CONTRACTOR RACHEL DOAN PHONE: Business Home 876-2117

ADDRESS 279 HICKS ROAD STATESVILLE, NC 28625

LOCATION NC115 NORTH, TR WILSON FARM ROAD, TL HICKS ROAD, LAST MH ON LEFT

SUBDIVISION BLOCK / SECTION LOT LOT AREA 1.9 ACRES SITE CLASS P5 DESIGN FLOW 360 L.T.A.R. 0.30 GPD/FT²

Septic Tank: EXISTING Gallons: STB Date

Pump Tank: Gallons: PT Date

Pump Make: Model Serial No

Nitrification Field: No Fields Square Feet 360 Linear Feet 120'

No Lines TWO Trench Width 36" Max Trench Bottom Depth 36" Gravel Depth 12"

☑ New System ☐ Repair System Type I II III IV V VI

System Description: CONVENTIONAL GRAVITY

Repair System Description: 50% REDUCTION GRAVITY

Maintenance Agreement Required: ☐ Yes ☑ No

☐ House/Mod. Home ☑ Mobile Home ☐ Business ☐ Other

No. Bedrooms 3 No. Bathrooms 2 No Employees


☐ Slab ☑ Crawl Space ☐ Basement w/plumbing ☐ Basement wo/plumbing

Water Supply: ☐ Individual ☐ Public ☐ Community

Comments/Conditions: TIE NEW 3'x50' AND 3'x70' LINES TO ENDS OF LOWER TWO LINES AS SHOWN BELOW

Comments/Conditions

INITIAL SITE SKETCH

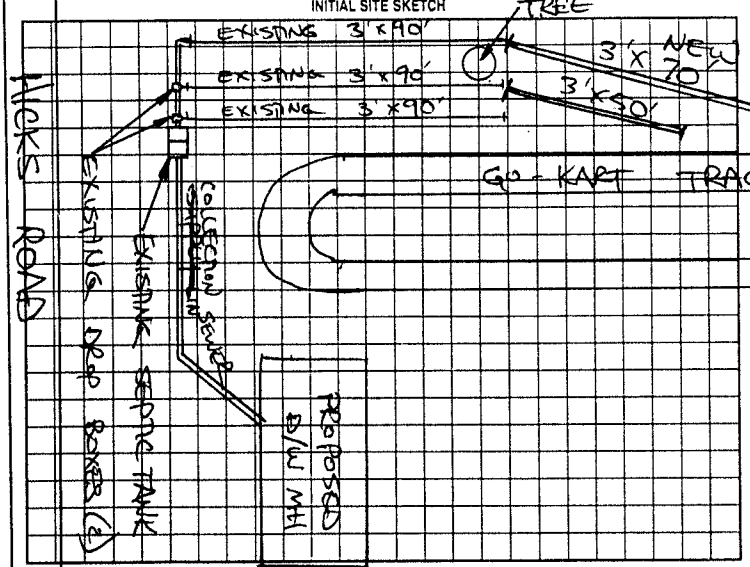

AS BUILT SKETCH

SYSTEM EXPANDED ACCORDING TO INITIAL SITE SKETCH

Permit can be suspended or revoked if any false information is supplied toward securing the permit/any unauthorized changes are made to the site/any unauthorized changes are made in the installation of the system. Improvement Permit with plat valid without expiration. Improvement Permit with site plan valid for sixty months. Authorization to Construct is valid for a period equal to that of Improvement Permit – not to exceed sixty months.

Signed: [signature] date 4.27.00 Installed by: A-1 BACKHOE

Improvement Permit by: STEVE HEDRICK date 4-27-00 Operation Permit by: STEVE HEDRICK date 5-10-00

Authorization to Construct by: STEVE HEDRICK date 4-27-00 Existing System Inspection by: date

HEALTH DEPT COPY WHITE OWNER COPY (FINAL) YELLOW OWNER COPY (INITIAL) PINK