IREDELL COUNTY HEALTH DEPARTMENT

STATESVILLE 704-878-5305 MOORESVILLE 704-664-5281

IMPROVEMENT PERMIT / CERTIFICATE OF COMPLETION / OPERATION PERMIT / EXISTING SYSTEM INSPECTION

PROPERTY DESCRIPTION NO. 067011 DATE 6-11-97 TAX MAP NO. 4820 31 4846

OWNER OR CONTRACTOR RACHEL DOAN PHONE: Business Home 876-2117

ADDRESS 287 HICKS ROAD, STATESVILLE, NC 28677 Watershed: ☐ Yes ☑ No

LOCATION NC 115 N, TR WILSON FARM, TL HICKS RD, AT END ON LEFT. (JUST PAST RAMBLING LANE)

SUBDIVISION BLOCK / SECTION LOT LOT AREA 2.0 ACRES SITE CLASS. PS DESIGN FLOW 270 L.T.A.R. 0.30 GPD/FT²

Septic Tank: 1000 Gallons; STB 1007 Date 5-23-97 ☑ New System ☐ Repair System Type: I, II, III, IV, V, VI

Pump Tank: Gallons; PT Date System Description: CONVENTIONAL GRAVITY

Pump Make: Model Serial No. Repair System Description: CONV. GRAVITY

Nitrification Field: No Fields 1 Square Feet 810 Linear Feet 270 Maintenance Agreement Required: ☐ Yes ☐ No

No Lines THREE Trench Width 36" Max Trench Bottom Depth 36" Gravel Depth 12" ☐ Slab ☑ Crawl Space ☐ Basement w/plumbing ☐ Basement wo/plumbing


☐ House/Mod. Home No. Bedrooms 3
☑ Mobile Home No. Bathrooms 2
☐ Business No. Employees
☐ Other

Water Supply: ☑ Individual ☐ Community ☐ Public WELL


Comments: KEEP SYSTEM MINIMUM 100' FROM WELL

Comments:

INITIAL SITE SKETCH

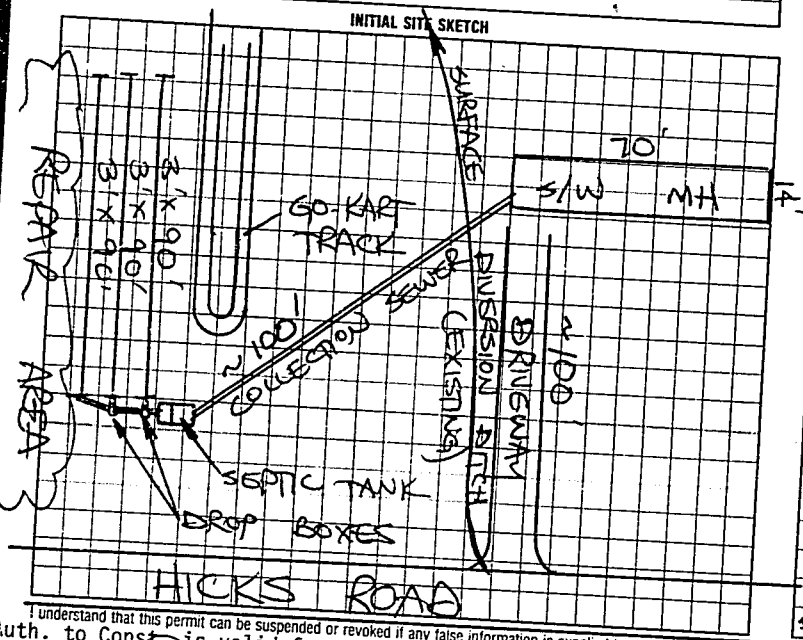

AS BUILT SKETCH

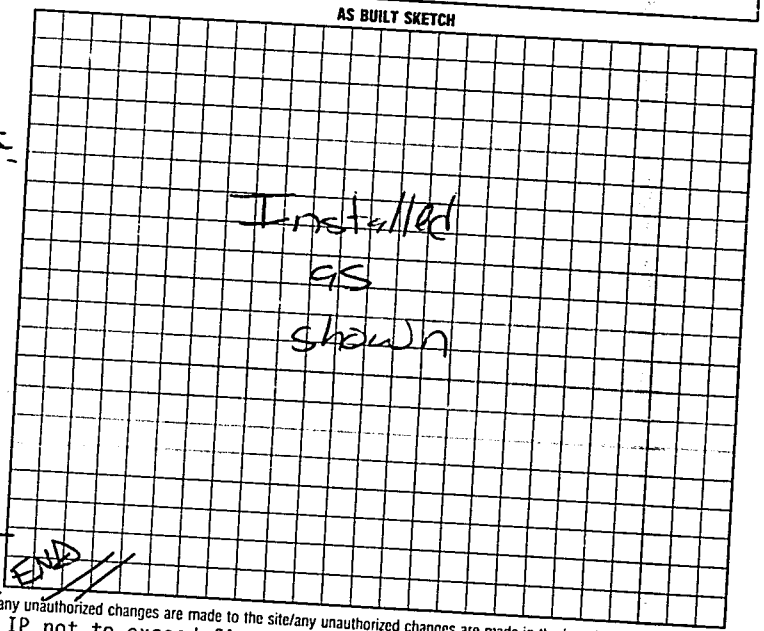

I understand that this permit can be suspended or revoked if any false information is supplied toward securing the permit/any unauthorized changes are made to the site/any unauthorized changes are made in the installation of the system.

Auth. to Const. is valid for a period equal to the validity of the IP not to exceed five years. IP w/site plan is valid five years.

Signed: Rachel Doan

Improvement Permit by: STEVE HEDRICK date 6-11-97

Authorization to Construct

Existing System Inspection by: STEVE HEDRICK date 6-11-97

XXXXXXXXXXXXXXXXX

Installed by: Shane Sweatt Cooling

Certificate of Completion by: date

Operation Permit by: Mark C. Of RS date 7-2-97

HEALTH DEPT. COPY: WHITE INSPECTION COPY (FINAL): GREEN OWNER COPY (FINAL): YELLOW INSPECTION COPY (INITIAL): PINK OWNER COPY (INITIAL): GOLD