IREDELL COUNTY HEALTH DEPARTMENT

STATESVILLE 704-878-5305 MOORESVILLE 704-664-5281

IMPROVEMENT PERMIT / AUTHORIZATION TO CONSTRUCT / OPERATION PERMIT / EXISTING SYSTEM INSPECTION

PERMIT# 093068 PIN# 4820 41 2455 DATE 11-29-00

OWNER OR CONTRACTOR CHRIS SULLIVAN PHONE: Business 876-9306 Home

ADDRESS 256 HICKS ROAD, STATESVILLE, NC 28625

LOCATION NC 115 N, TR WILSON FARM RD, TL HICKS ROAD, AT END ON RIGHT

SUBDIVISION BLOCK / SECTION LOT LOT AREA 1.0 ACRE SITE CLASS PS DESIGN FLOW 360 L.T.A.R. 0.35 GPD/FT²

Septic Tank: 1000 Gallons; STB 1012 Date 9-4-00
Pump Tank: Gallons; PT Date
Pump Make: Model Serial No.
Nitrification Field: No Fields 1 Square Feet 1035 Linear Feet 345
No Lines FIVE Trench Width 36" Max Trench Bottom Depth 36" Gravel Depth 12"

☐ New System ☐ Repair System Type: I (II) III IV V VI
System Description: CONVENTIONAL GRAVITY
Repair System Description: DRIP IRRIGATION
Maintenance Agreement Required: ☐ Yes ☒ No


☐ House/Mod. Home No. Bedrooms 3
☒ Mobile Home No. Bathrooms 2
☐ Business No. Employees
☐ Other
☐ Slab ☒ Crawl Space ☐ Basement w/plumbing ☐ Basement wo/plumbing

Water Supply: ☒ Individual ☐ Public ☐ Community WELL


Comments/Conditions: KEEP SYSTEM MINIMUM 100 FEET FROM WELL

Comments /Conditions: SEPTIC TANK W/ RISERS INSTALLED USING "POLY LOK" FILTER

INITIAL SITE SKETCH

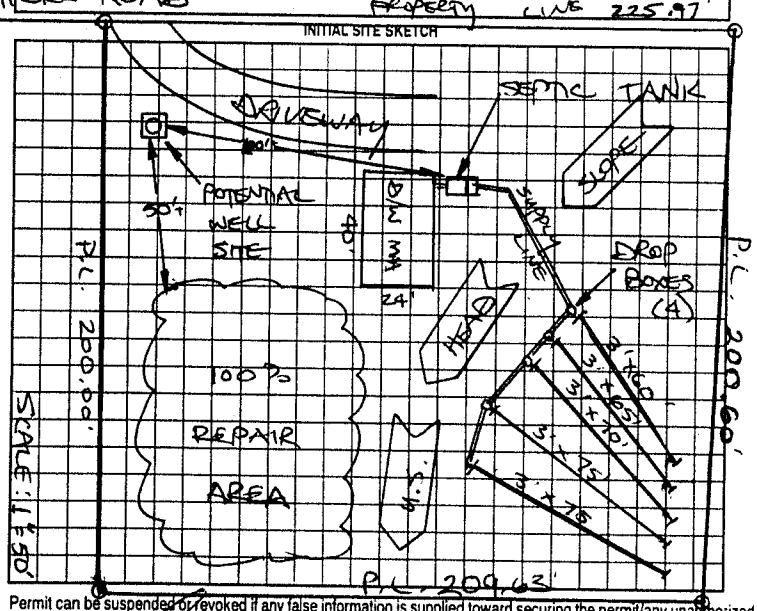

AS BUILT SKETCH

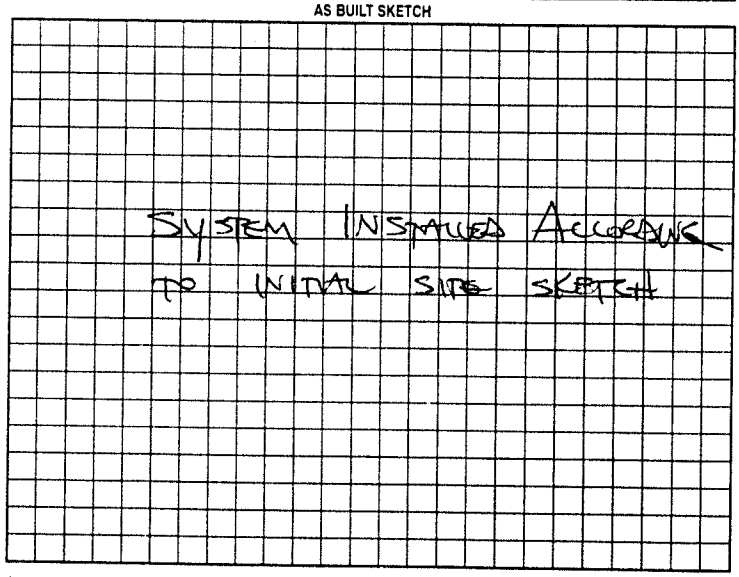

Permit can be suspended or revoked if any false information is supplied toward securing the permit/any unauthorized changes are made to the site/any unauthorized changes are made in the installation of the system. Improvement Permit with plat valid without expiration. Improvement Permit with site plan valid for sixty months. Authorization to Construct is valid for a period equal to that of Improvement Permit – not to exceed sixty months.

Signed: X Chris Sullivan date 11-29-00 Installed by: STATESVILLE BACKHOE

Improvement Permit by: STEVE HEDRICK date 11-29-00 Operation Permit by: STEVE HEDRICK date 12-1-00

Authorization to Construct by: STEVE HEDRICK date 11-29-00 Existing System Inspection by: date

HEALTH DEPT. COPY: WHITE OWNER COPY (FINAL): YELLOW OWNER COPY (INITIAL): PINK