IREDELL COUNTY HEALTH DEPARTMENT

Statesville Office (704) 878-5305 Mooresville Office (704) 660-3625 PERMIT # 21777

IMPROVEMENT PERMIT / AUTHORIZATION TO CONSTRUCT / OPERATION PERMIT / EXISTING SYSTEM

PIN # 4820466621 r

APPLICANT: Lori Johnson APPLICANT ADDRESS: 100 Gator Hollow Ln Statesville NC 28625

SITE ADDRESS: 100 Gator Hollow Ln Statesville NC PHONE: 704-880-1770 ALT. PHONE: 704-876-2824

SITE DIRECTIONS: 115 N T/R Tvickers Grove Rd T/R Gator Hollow Ln Take immediate right


SUBDIVISION: N/A SECTION: N/A LOT # N/A LOT AREA: 3.0ac DESIGN FLOW: 360 L.T.A.R.: 0.3

Septic Tank	1000 (gal)	STB	760	Date	4/4	[X] New System	[ ] Repair	[ ] Expansion	System Type: I II [III] IV V VI	[X] Residence	No. Bedrooms 3
Pump Tank	(gal)	PT		Date		System Description:		25% Reduction		[ ] Business	No. Persons 6
Pump Make		Model		Serial #		Repair System Description:		50% Reduction		[ ] Other	No. Employees
# Nitrification Fields	1	# Lines	3	Linear Ft:	360	Maintenance Agreement Required:		[ ] YES	[X] NO	[ ] Slab	[X] Crawl Space
Trench Width	36"	Max. Trench Bottom Depth	36"	Gravel Depth	N/A	[X] GRAVITY		[ ] PRESSURE		[ ] Basement w/plumbing	[ ] Basement w/o plumbing


Water Supply: [✓] Private [ ] Public [ ] Community

Comments / Conditions: Install 25% reduction on contour with Serial distribution.

INITIAL SITE SKETCH

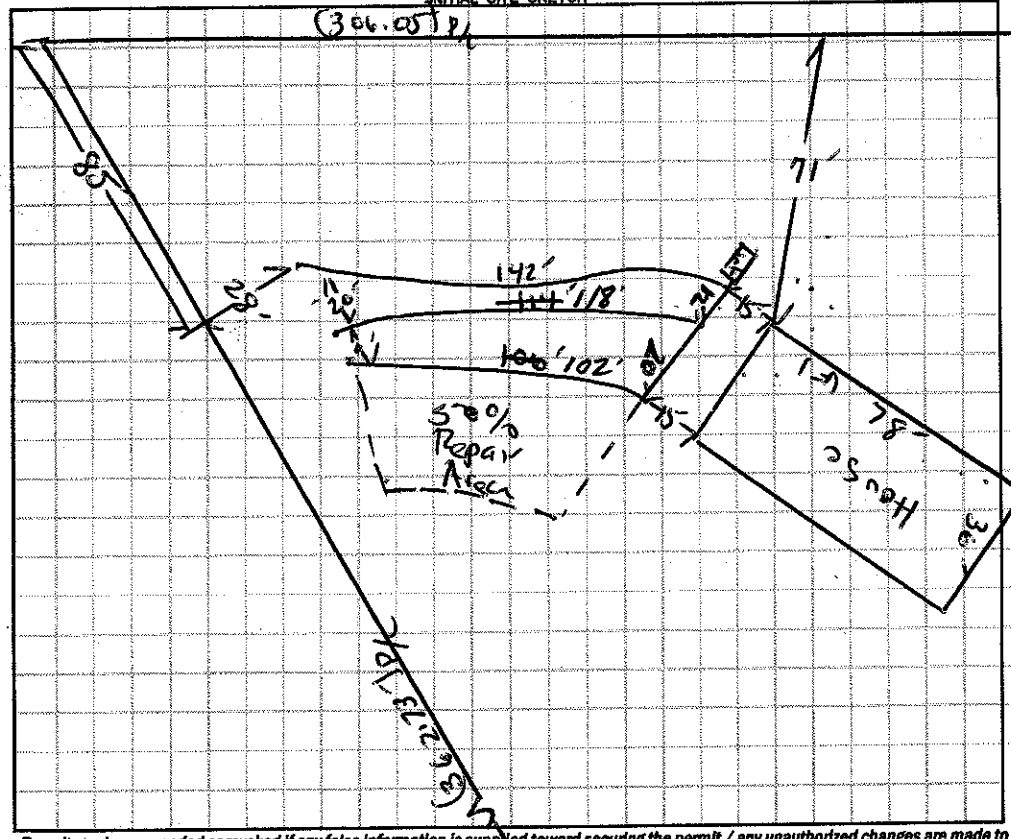

AS BUILT SKETCH

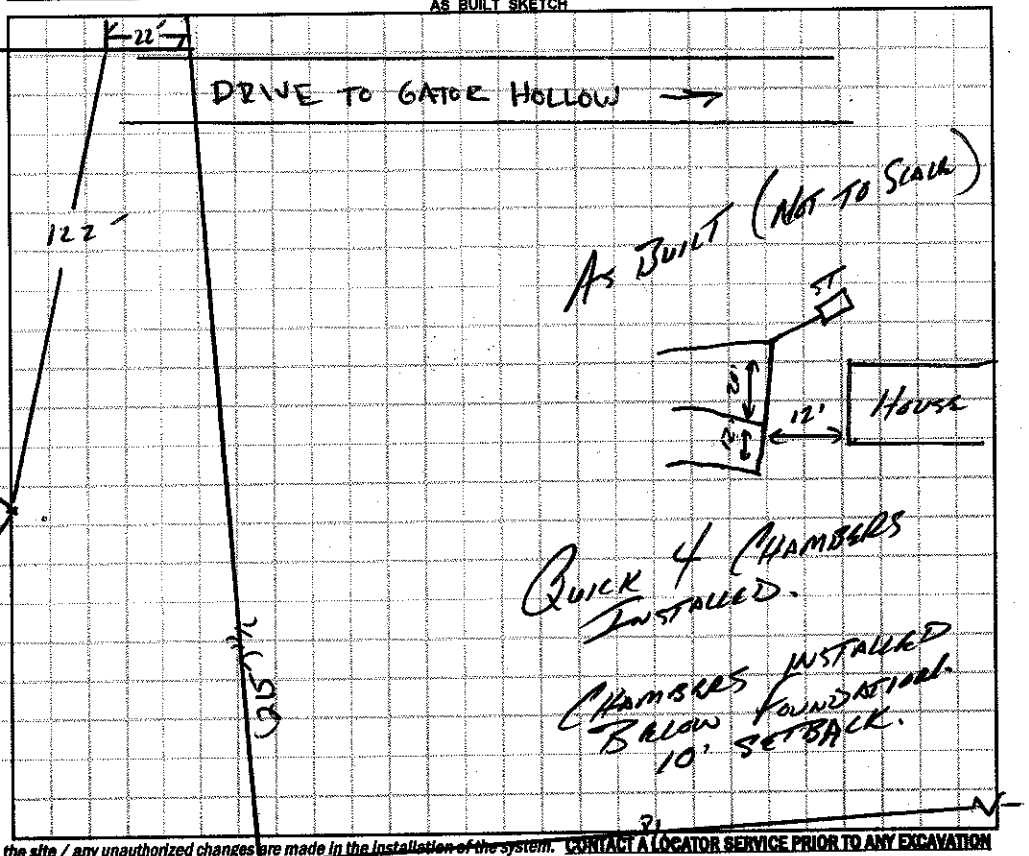

Permit can be suspended or revoked if any false information is supplied toward securing the permit / any unauthorized changes are made to the site / any unauthorized changes are made in the installation of the system. CONTACT A LOCATOR SERVICE PRIOR TO ANY EXCAVATION

[ ] IMPROVEMENT PERMIT *with plat* valid without expiration. [X] IMPROVEMENT PERMIT *with site plan* valid for 60 mos. [X] AUTHORIZATION TO CONSTRUCT valid for period equal to IMPROVEMENT PERMIT--not to exceed 60 mo.

Owner / Applicant Signature: Lori Johnson Date: 5/9/16 Installed by: Travis Brookens

IMPROVEMENT PERMIT by: Date: 05/09/16 OPERATION PERMIT by: Date: 6/21/16

AUTHORIZATION TO CONSTRUCT by: Date: 05/09/16 Existing System Inspected by: Date:

Health Dept. Copy - WHITE Applicant (Final Approval) - YELLOW Applicant (Conditional Approval) - PINK