IREDELL COUNTY HEALTH DEPARTMENT - *ENVIRONMENTAL HEALTH* ☑ STATESVILLE OFFICE 704-878-5305 ☐ MOORESVILLE OFFICE 704-664-5281

IMPROVEMENT PERMIT / AUTHORIZATION TO CONSTRUCT / OPERATION PERMIT / EXISTING SYSTEM INSPECTION

PERMIT # REPAIR PIN # 4820-59-0746 DATE FEBRUARY 2, 2012

OWNER CHERYL MENLEN APPLICANT: SAME PHONE: Home/Cell # 586-292-4147 Business #

SITE ADDRESS 629 TUCKERS GROVE ROAD, STVL OWNER / APPLICANT ADDRESS

SITE DIRECTIONS NC 115 NORTH, TR BRUCE RD, TR TUCKERS GROVE RD, 0.3 MILE ON RIGHT AT BOX 629

SUBDIVISION BILL B SWANSON FARM BLOCK / SECTION LOT # 16 & 17 LOT AREA 20.99 ACRES DESIGN FLOW 480 L.T.A.R. EXISTING

NEW

Septic Tank 1000 Gallons: STB 620 Date 6-22-11

Pump Tank Gallons: PT Date

Pump Make Model Serial #

No. Nitrification Fields: 1 No. Lines 5 Linear Feet 533 (EXIST)

Trench Width EX Max. Trench Bottom Depth EX

☐ New System ☑ Repair ☐ Expansion System Type I (II) III IV V VI

System Description: CONVENTIONAL GRAVITY

Repair System Description: TANK REPLACEMENT

Maintenance Agreement Required ☐ YES ☑ NO

Gravel Depth 12" (EX) ☑ GRAVITY ☐ PRESSURE

☑ Residence No. Bedrooms 4

☐ Business No. Persons

☐ Other No. Employees

☑ Slab ☑ Crawl Space


☐ Basement w/plumbing ☐ Basement w/o plumbing

Water Supply: ☑ Private WELL ☐ Public ☐ Community

Comments / Conditions CRUSH & FILL EXISTING SEPTIC TANK. REPLACE WITH NEW 1000 GALLON SEPTIC TANK AS SHOWN

SEPTIC TANK WITH MARKER INSTALLED USING RED "POLYLOK" FILTER

INITIAL SITE SKETCH

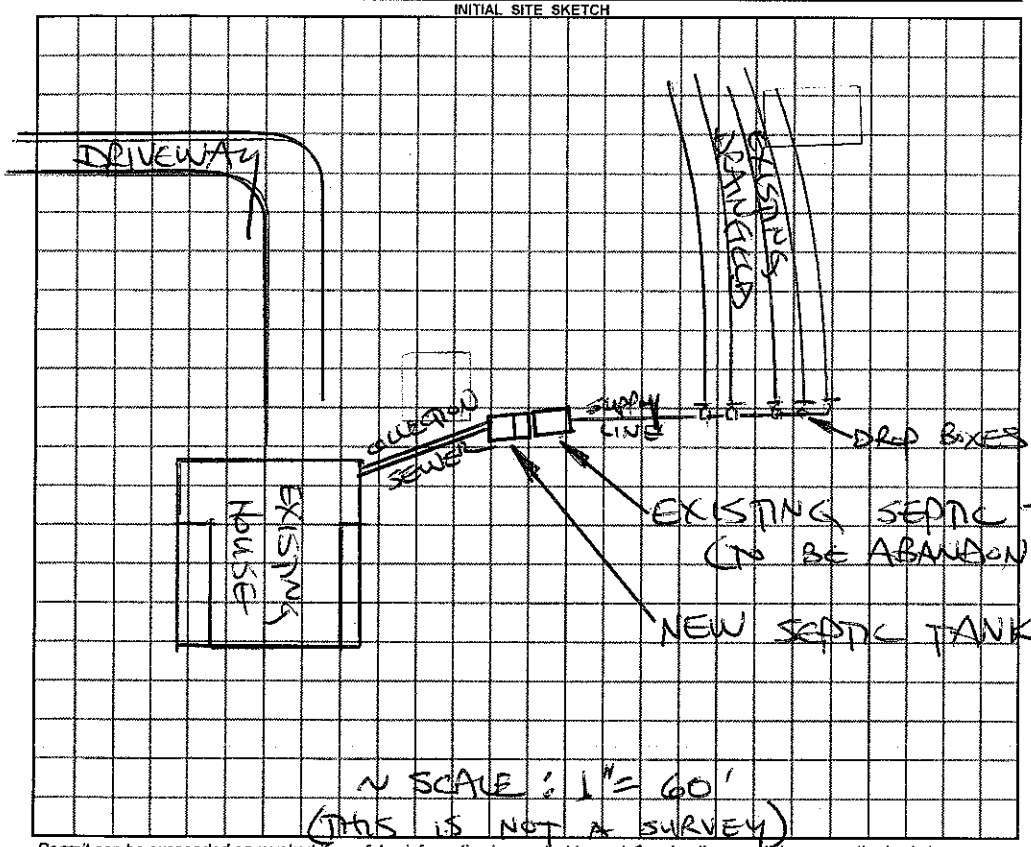

AS BUILT SKETCH

SEPTIC TANK WAS REPLACED AT SAME LOCATION AS THE ORIGINAL TANK

Permit can be suspended or revoked if any false information is supplied toward securing the permit / any unauthorized changes are made to the site / any unauthorized changes are made in the installation of the system.

☐ ***IMPROVEMENT PERMIT*** *with plat valid without expiration.* ☑ ***IMPROVEMENT PERMIT*** *with plat valid without expiration.* site plan valid 60 mo.

☑ ***AUTHORIZATION TO CONSTRUCT*** valid for period equal to IMPROVEMENT PERMIT–not to exceed 60 mo.

Owner / Applicant Signature: [signature] Date 2-2-12 Installed by: SAMMY REAVIS

IMPROVEMENT PERMIT by: STEVE HEDRICK REHS Date 2-2-2012 OPERATION PERMIT by: R. STEVE HEDRICK REHS Date 2-16-12

AUTHORIZATION TO CONSTRUCT by: STEVE HEDRICK REHS Date 2-2-2012 Existing System Inspected by: REHS Date

YOU SHOULD CONTACT A LOCATOR SERVICE PRIOR TO ANY EXCAVATION

White Copy – Environmental Health YELLOW COPY (Final) Owner / Applicant PINK COPY (Initial) Owner / Applicant