IREDELL COUNTY HEALTH DEPARTMENT

STATESVILLE 704-878-5305 MOORESVILLE 704-664-5281

IMPROVEMENT PERMIT / CERTIFICATE OF COMPLETION / OPERATION PERMIT / EXISTING SYSTEM INSPECTION

PROPERTY DESCRIPTION NO. 067824 DATE 7-14-97 TAX MAP NO. 4821514201 Watershed: ☐ Yes ☑ No

OWNER OR CONTRACTOR ALAN & DEBBIE FANN PHONE: Business Home 892-4825

ADDRESS 20419 SHEARERS ROAD DAVIDSON NC 28036

LOCATION NC 115 N, TR BRUCE, TR TUCKERS GROVE, ~ 1000' ON RIGHT, 350' OFF ROAD

SUBDIVISION BLOCK / SECTION LOT LOT AREA 21± ACRES SITE CLASS. P3 DESIGN FLOW 480 L.T.A.R. 0.30 GPD/FT²

Septic Tank: 1000 Gallons; STB 1012 Date 5-16-97

Pump Tank: Gallons; PT Date

Pump Make: Model Serial No.

Nitrification Field: No Fields 1 Square Feet 1600 Linear Feet 533

No Lines FIVE Trench Width 36" Max Trench Bottom Depth 36" Gravel Depth 12"

☑ New System ☐ Repair System Type: I, ☑ II, IV, V, VI

System Description: CONVENTIONAL GRAVITY

Repair System Description: CONV. GRAVITY

Maintenance Agreement Required: ☐ Yes ☑ No

☑ House/Mod. Home No. Bedrooms 4

☐ Mobile Home No. Bathrooms 3

☐ Business No. Employees

☐ Other W/ GARAGE PLUMBING


☑ Slab ☑ Crawl Space ☐ Basement w/plumbing ☐ Basement wo/plumbing

Water Supply: ☑ Individual ☐ Community ☐ Public WELL


Comments: ① KEED SYSTEM MINIMUM 100' FROM WELL
② INSTALL LINES ON CONTOUR AS FLAGGED

Comments:

INITIAL SITE SKETCH SCALE: 1"=50'

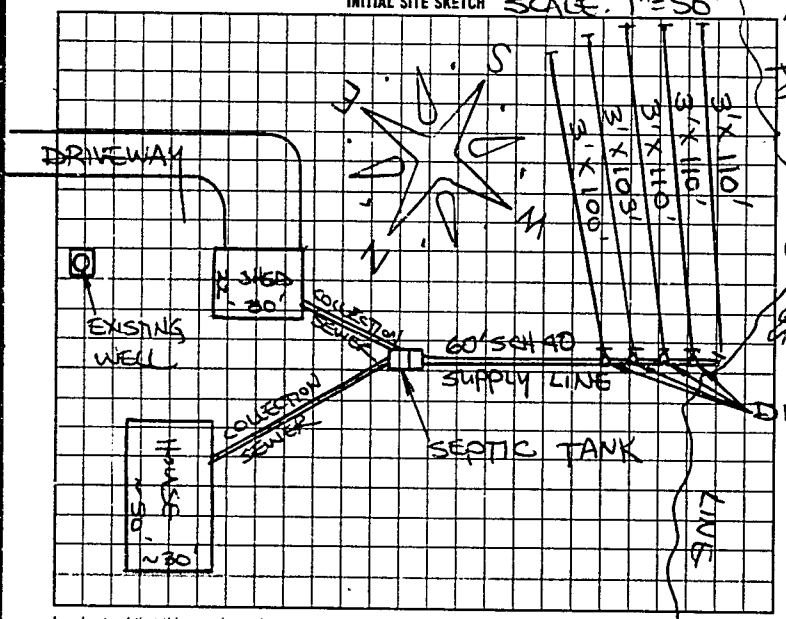

AS BUILT SKETCH

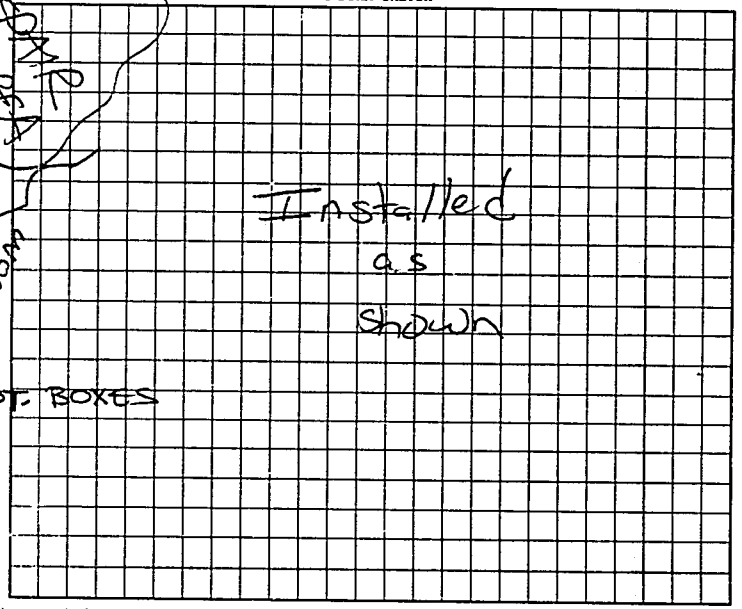

I understand that this permit can be suspended or revoked if any false information is supplied toward securing the permit/any unauthorized changes are made to the site/any unauthorized changes are made in the installation of the system. Improvement Permit is valid for 60 months from date of issue. AUTHORIZATION TO CONSTRUCT IS VALID FOR 60 MONTHS FROM DATE OF ISSUE.

Signed: Alan Fann

Improvement Permit by: STEVE HENDRICK date 7-14-97

AUTH. TO CONST. Existing System Inspection by: STEVE HENDRICK date 7-14-97

Installed by: A-1 Backhoe

~~Certificate of Completion by:~~ date

Operation Permit by: Mark C Outlaw RS date 7-17-97

HEALTH DEPT. COPY: WHITE INSPECTION COPY (FINAL): GREEN OWNER COPY (FINAL): YELLOW INSPECTION COPY (INITIAL): PINK OWNER COPY (INITIAL): GOLD

LLSUOO