IREDELL COUNTY HEALTH DEPARTMENT

STATESVILLE 704-878-5305 (C1) MOORESVILLE 704-664-5281

IMPROVEMENT PERMIT / AUTHORIZATION TO CONSTRUCT / OPERATION PERMIT / EXISTING SYSTEM INSPECTION

PERMIT# 127778 PIN# 4820-60-~~6883~~ 7962 DATE 6-7-05

OWNER OR CONTRACTOR LINDA D. WANSLEY PHONE: Business Home (704) 876-4855

ADDRESS 247 GRANT RD. STATESVILLE, NC 28625

LOCATION HWY 115N (R) DOBSON FARM (R) GRANT LOT 3/10 MI ON LEFT

SUBDIVISION BLOCK / SECTION LOT LOT AREA 1.5 SITE CLASS PS DESIGN FLOW 360 L.T.A.R. 0.30 GPD/FT²

Septic Tank: 1000 Gallons; STB 1007 Date 8-6-05
Pump Tank: Gallons; PT Date
Pump Make: Model Serial No.
Nitrification Field: No Fields 1 Square Feet 1200 Linear Feet 400
No Lines THREE (3) Trench Width 36" Max Trench Bottom Depth 36" Gravel Depth 12"

☑ New System ☐ Repair System Type: I, (II), III, IV, V, VI
System Description: CONVENTIONAL GRAVITY
Repair System Description: SAME
Maintenance Agreement Required: ☐ Yes ☑ No


☑ House/Mod. Home No. Bedrooms 3
☐ Mobile Home No. Bathrooms
☐ Business No. Employees
☐ Other
☐ Slab ☐ Crawl Space ☑ Basement w/plumbing ☐ Basement wo/plumbing

Water Supply: ☑ Individual ☐ Public ☐ Community


Comments:/Conditions: ① INSTALL DRAINFIELD NO DEEPER THAN 36" ON CONTOUR ② MAINTAIN SETBACKS

Comments:/Conditions: SEPTIC TANK WITH MARKER INSTALLED USING "ZABEL" FILTER

INITIAL SITE SKETCH

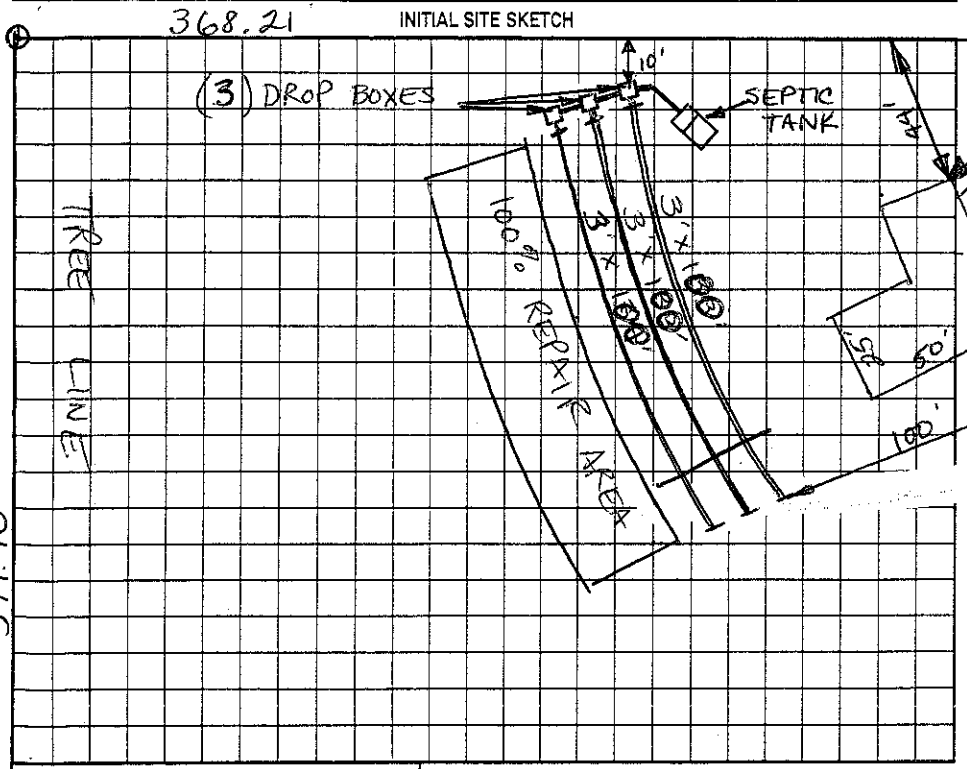

AS BUILT SKETCH

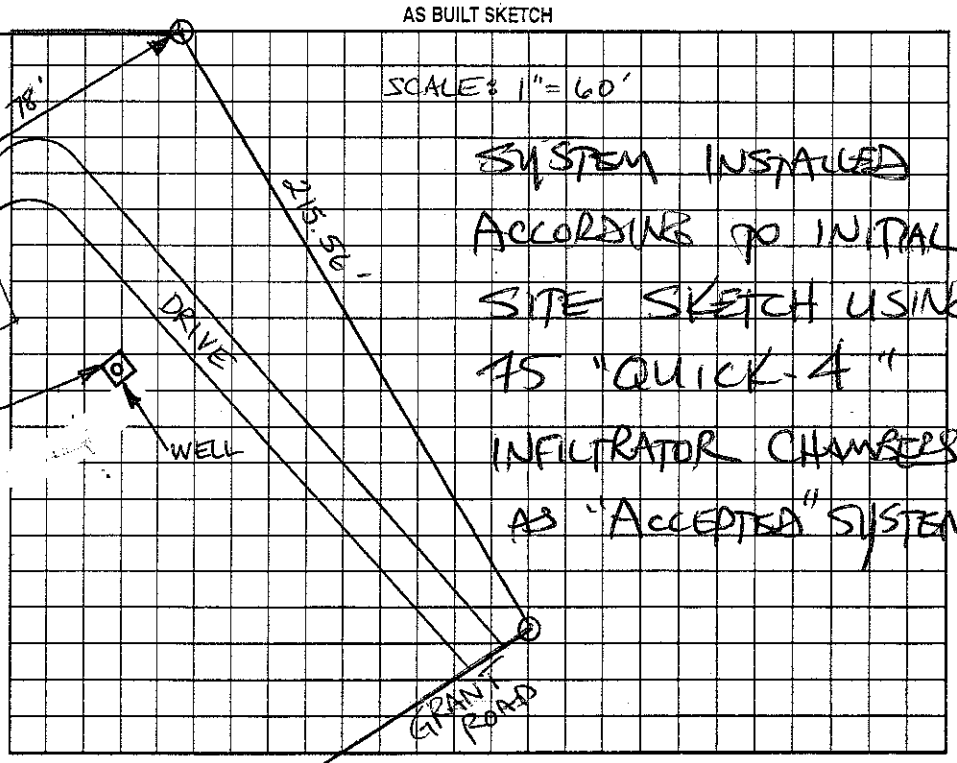

SYSTEM INSTALLED ACCORDING TO INITAL SITE SKETCH USING 45 "QUICK-4" INFILTRATOR CHAMBERS AS "ACCEPTED" SYSTEM

Permit can be suspended or revoked if any false information is supplied toward securing the permit/any unauthorized changes are made to the site/any unauthorized changes are made in the installation of the system. Improvement Permit with plat valid without expiration. Improvement Permit with site plan valid for sixty months. Authorization to Construct is valid for a period equal to that of Improvement Permit – not to exceed sixty months.

Signed: Linda D. Wansley date 6-9-05
Improvement Permit by: Christopher M. Sherrill RS, LSS date 6-7-05
Authorization to Construct by: Christopher M. Sherrill RS date 6-7-05
LSS

Installed by: A & C GRADING
Operation Permit by: STEVE HENDRICK date 9-15-05
Existing System Inspection by: date

HEALTH DEPT. COPY: WHITE OWNER COPY (FINAL): YELLOW OWNER COPY (INITIAL): PINK