IREDELL COUNTY HEALTH DEPARTMENT

THIS PERMIT REPLACES PERMIT # 119764 ISSUED 5/13/2009

STATESVILLE 704-878-5305 MOORESVILLE 704-664-5281

IMPROVEMENT PERMIT / AUTHORIZATION TO CONSTRUCT / OPERATION PERMIT / EXISTING SYSTEM INSPECTION

PERMIT # 176020 PIN # 4820-61-9298 DATE NOVEMBER 20, 2012

OWNER or APPLICANT W. THOMAS CHEATHAM PHONE: Business 704-880-1601 Home:

OWNER or APPLICANT ADDRESS P.O. BOX 5895 STATESVILLE NC 28687

LOCATION / DIRECTIONS NC 115 NORTH, TR HAM'S GROVE RD TL GRANT ROAD, 0.7 MILE ON RIGHT

SUBDIVISION N/A BLOCK / SECTION N/A LOT # N/A LOT AREA 1.29 AC DESIGN FLOW 240 L.T.A.R. 0.30 GPD/FT2

Septic Tank 1000 Gallons: STB 760 Date 7-17-12

Pump Tank Gallons: P T Date

Pump Make Model Serial #

Nitrification Field No Fields 1 No Lines 3 Linear Feet 200+

Trench Width 36" Max. Trench Bottom Depth 24" Gravel Depth N/A

☑ New System ☐ Repair ☐ Expansion System Type I II (III) IV V VI

System Description: 25% REDUCTION GRAVITY

Repair System Description: 25% REDUCTION, GRAVITY

Maintenance Agreement Required ☐ YES ☑ NO

☑ GRAVITY ☐ PRESSURE

☑ Residence No. Bedrooms 2

☐ Business No. Persons

☐ Other No. Employees

☐ Slab ☑ Crawl Space


☐ Basement w/plumbing ☐ Basement w/o plumbing

Water Supply: ☑ Private WELL ☐ Public ☐ Community


Comments / Conditions: INSTALL 25% REDUCTION SYSTEM ON CONTOUR AS SHOWN, NO DEEPER THAN 24 INCHES. USE SERIAL DISTRIBUTION

Comments / Conditions: SEPTIC TANK WITH MARKER INSTALLED USING REA "POLY LOK" FILTER

INITIAL SITE SKETCH

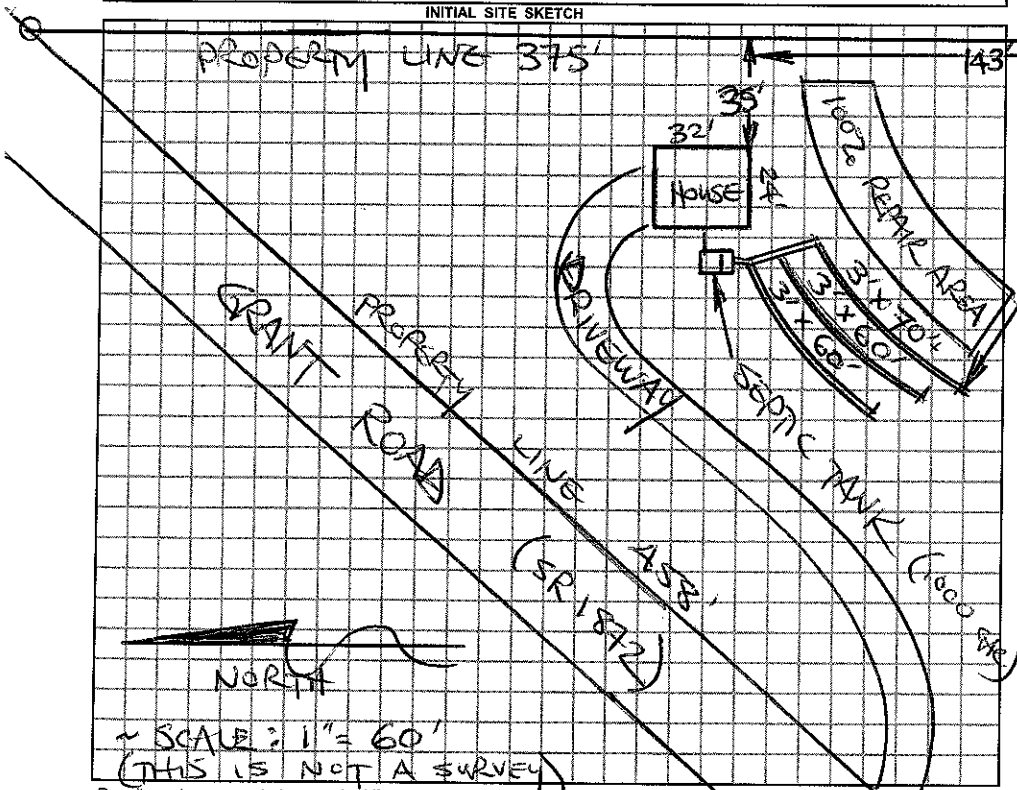

AS BUILT SKETCH

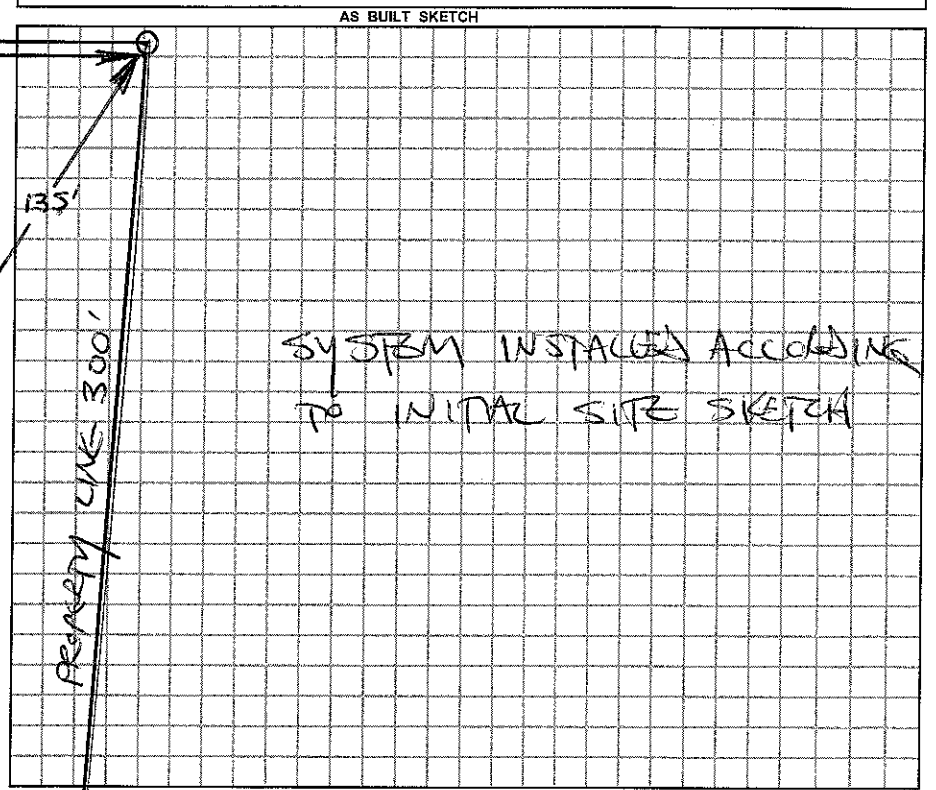

Permit can be suspended or revoked if any false information is supplied toward securing the permit / any unauthorized changes are made to the site / any unauthorized changes are made in the installation of the system.

☐ *IMPROVEMENT PERMIT w / plat valid without expiration* ☑ *IMPROVEMENT PERMIT w / site plan valid for 60 mos.* ☑ *AUTHORIZATION TO CONSTRUCT valid for period equal to IMPROVEMENT PERMIT-not to exceed 60 mo.*

Owner / Applicant Signature: William Thomas Cheatham Date 11-21-12

Improvement Permit by: R. STEVE HENDRICK Date 11/20/12

Authorization to Construct by: R. STEVE HENDRICK Date 11/20/12

Installed by: A-1 BACKHOE

Operation Permit by: STEVE HENDRICK Date: 11/26/12

Existing System Inspected by: Date:

YOU SHOULD CONTACT A LOCATOR SERVICE PRIOR TO ANY EXCAVATION.

WHITE COPY Environmental Health YELLOW COPY (Final) Owner / Applicant PINK COPY (Initial) Owner / Applicant

