IREDELL COUNTY HEALTH DEPARTMENT

Statesville Office (704) 878-5305 Mooresville Office (704) 660-3625

PERMIT # 206974

PIN # 4820688986

IMPROVEMENT PERMIT / AUTHORIZATION TO CONSTRUCT / OPERATION PERMIT / EXISTING SYSTEM

APPLICANT: Judith Tolliver APPLICANT ADDRESS: 513 Tuckers Grove Rd.

SITE ADDRESS: 513 Tuckers Grove Rd. PHONE: 704-876-4096 ALT. PHONE: N/A

SITE DIRECTIONS: Hwy 115 N TR Tuckers Grove Rd. Property on Left.

SUBDIVISION: N/A SECTION: N/A LOT # N/A LOT AREA: 0.9 acres DESIGN FLOW: 240gpd L.T.A.R.: Existing

Septic Tank Ex (gal) STB Date

Pump Tank (gal) PT Date

Pump Make Model Serial #

Nitrification Fields Ex # Lines Ex Linear Ft: Ex

Trench Width Ex Max. Trench Bottom Depth Ex Gravel Depth Ex

☐ New System ☐ Repair ☐ Expansion System Type: I (II) III IV V VI

System Description: Conventional

Repair System Description:

Maintenance Agreement Required: ☐ YES ☐ NO

☐ GRAVITY ☐ PRESSURE

☑ Residence ☐ Business ☐ Other ☐ Slab ☐ Basement w/plumbing


No. Bedrooms 2 No. Persons 4 No. Employees ____ ☑ Crawl Space ☐ Basement w/o plumbing

Water Supply: ☑ Private ☐ Public ☐ Community


Comments / Conditions:

New SWMH to be located in same location as previous SWMH, maintaining a minimum of 5' between home foundation & septic system. Also maintain a min of 25' between well & building foundation.

INITIAL SITE SKETCH

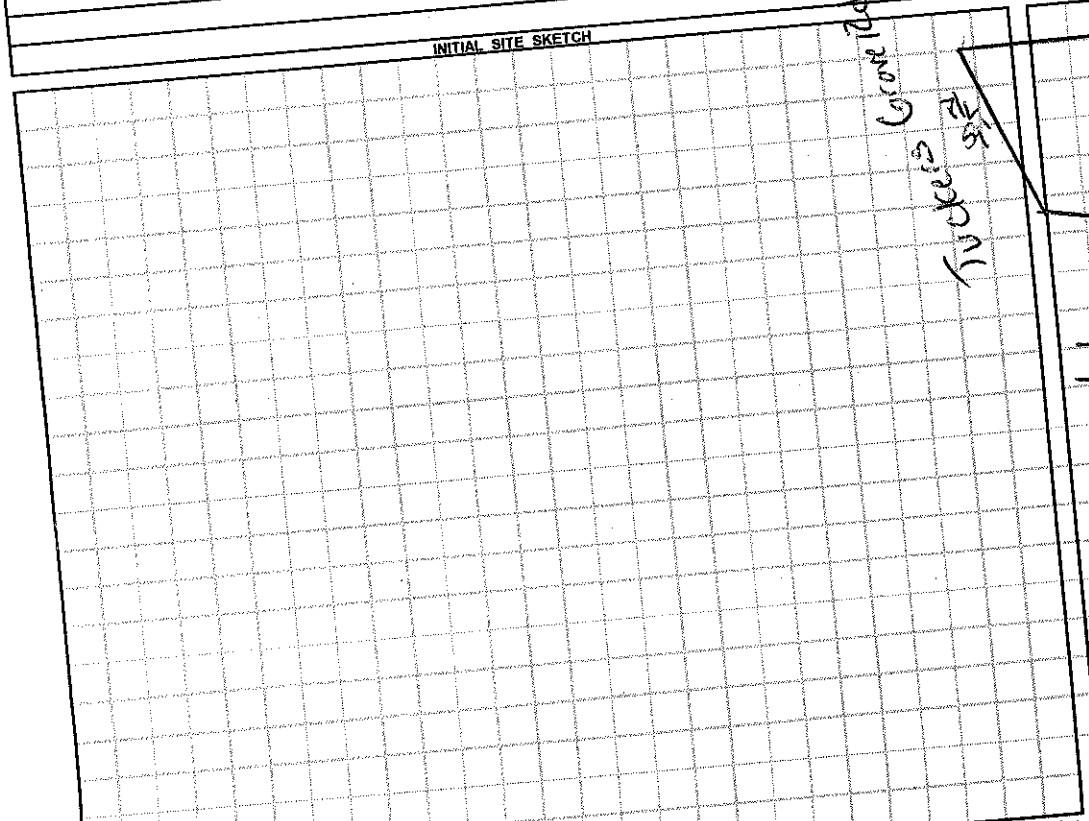

AS BUILT SKETCH

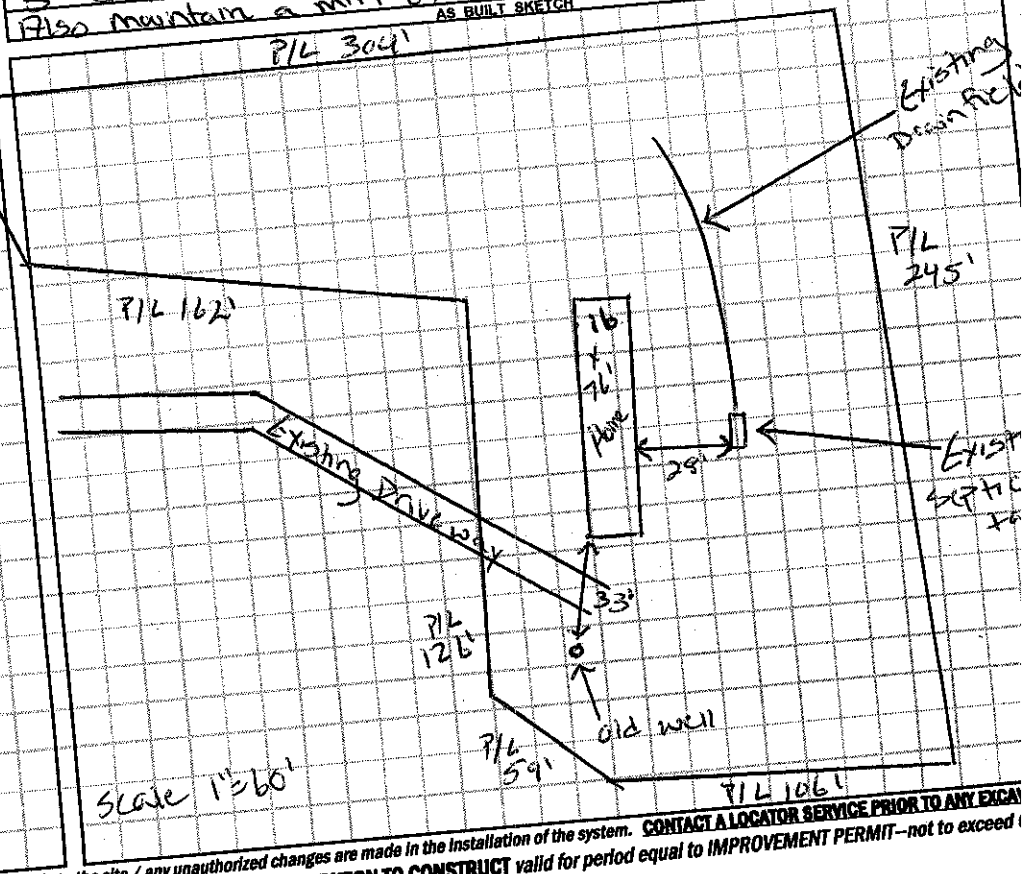

Permit can be suspended or revoked if any false information is supplied toward securing the permit / any unauthorized changes are made to the site / any unauthorized changes are made in the installation of the system. CONTACT A LOCATOR SERVICE PRIOR TO ANY EXCAV

☐ IMPROVEMENT PERMIT with plat valid without expiration.

☐ IMPROVEMENT PERMIT with site plan valid for 60 mos.

☐ AUTHORIZATION TO CONSTRUCT valid for period equal to IMPROVEMENT PERMIT--not to exceed

Owner / Applicant Signature: Judith Tolliver Date:

IMPROVEMENT PERMIT by: Date:

Installed by: Date:

OPERATION PERMIT by: Date: 11-25

Existing System Inspected by: Justin Henderson Date:

YELLOW - Applicant (Conditional Approval) - PINK