IREDELL COUNTY HEALTH DEPARTMENT

STATESVILLE 704-878-5305 MOORESVILLE 704-664-5281

IMPROVEMENT PERMIT / CERTIFICATE OF COMPLETION / OPERATION PERMIT / EXISTING SYSTEM INSPECTION

PROPERTY DESCRIPTION NO. 2556-17-068278 DATE 12-6-96 TAX MAP NO. 14 H - A - 16 Watershed: ☐ Yes ☑ No

OWNER OR CONTRACTOR Tony C. Hinson PHONE: Business _____ Home 872-4341

ADDRESS 253 St. Jill circle

LOCATION N.C. 115 N TR Tucker's Grove Rd Cross creek 1/4 mi Rt

SUBDIVISION _____ BLOCK / SECTION _____ LOT _____ LOT AREA 3 acres SITE CLASS. PJ DESIGN FLOW 360 L.T.A.R. .33

Septic Tank: 1000 Gallons; STB _____ Date 3-6-98
Pump Tank: _____ Gallons; PT _____ Date _____
Pump Make: _____ Model _____ Serial No. _____
Nitrification Field: No Fields 1 Square Feet 1080 Linear Feet 360
No Lines 3 Trench Width 36" Max Trench Bottom Depth 24" Gravel Depth 12"

☑ New System ☐ Repair System Type: I (II) III, IV, V, VI
System Description: Conv. Gravity
Repair System Description: "
Maintenance Agreement Required: ☐ Yes ☑ No


☑ House/Mod. Home No. Bedrooms 3
☐ Mobile Home No. Bathrooms 1 1/2
☐ Business No. Employees _____
☐ Other _____
☐ Slab ☐ Crawl Space ☐ Basement w/plumbing ☑ Basement wo/plumbing

Water Supply: ☑ Individual ☐ Community ☐ Public

Comments: Repair

Comments: * Note Hit Rock 1/2 way in 2nd line Bridged w/solid line - rest lines OK Added extra to upper line

INITIAL SITE SKETCH

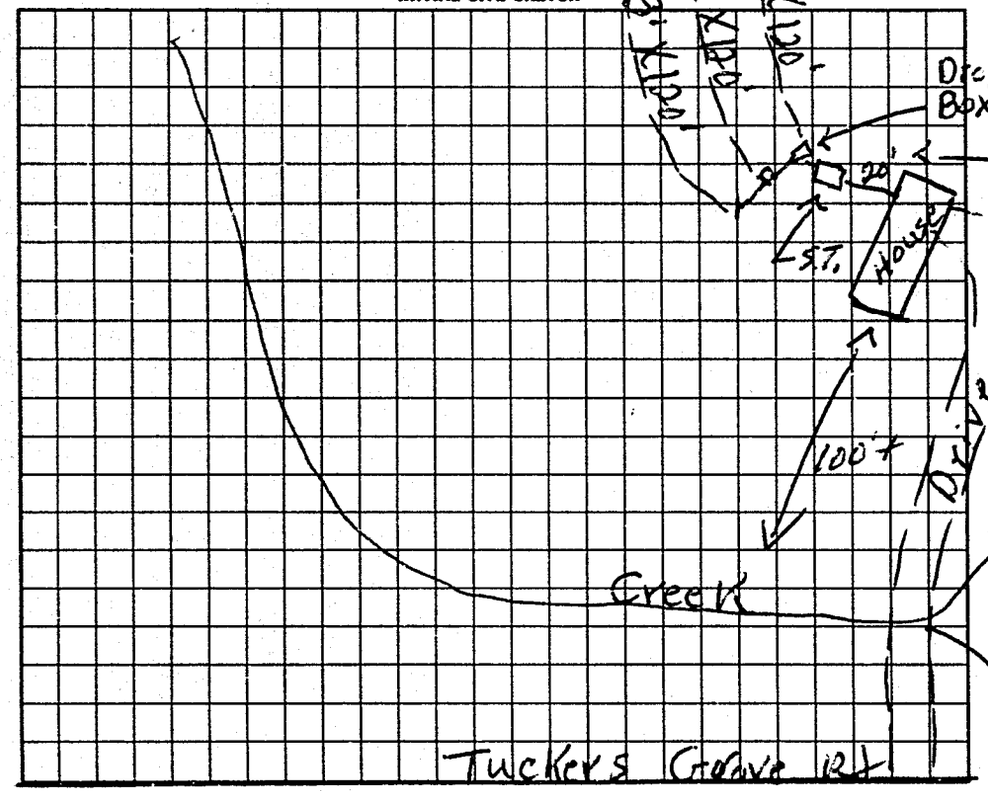

AS BUILT SKETCH

Installed as shown

I understand that this permit can be suspended or revoked if any false information is supplied toward securing the permit/any unauthorized changes are made to the site/any unauthorized changes are made in the installation of the system. Improvement Permit is valid for 60 months from date of issuance.

Signed: X Tony C. Hinson Installed by: Kenny Madison

Improvement Permit by: L. C. Moore date 12-6-96 Certificate of Completion by: _____ date _____

Authorization to Count by: L. C. Moore date 12-6-96 Operation Permit by: Maj C Autry RS date 5-18-98

Authorization to count EXPIRED 60 mos from issue

HEALTH DEPT. COPY: WHITE INSPECTION COPY (FINAL): GREEN OWNER COPY (FINAL): YELLOW INSPECTION COPY (INITIAL): PINK OWNER COPY (INITIAL): GOLD

15610