IREDELL COUNTY HEALTH DEPARTMENT

STATESVILLE 704-878-5305 MOORESVILLE 704-664-5281

IMPROVEMENT PERMIT / AUTHORIZATION TO CONSTRUCT / OPERATION PERMIT / EXISTING SYSTEM INSPECTION

PERMIT # 158737 PIN # 4820 79 2254 DATE 11-3-09

OWNER or APPLICANT Sandra LeCroy PHONE: Business 704-456-2779 Home: 704 876 9039

OWNER or APPLICANT ADDRESS 508 Tuckus Grove

LOCATION / DIRECTIONS 115N TR Tuckus Grove 508 Tuckus Grove RD on right in wooded area

SUBDIVISION BLOCK / SECTION LOT # LOT AREA 5.24 Ac DESIGN FLOW 360 L.T.A.R. 0.54

Septic Tank 1600/ DVST Gallons: STB Date

Pump Tank Gallons: P T Date

Pump Make Model Serial #

Nitrification Field No Fields 1 No Lines 2 Linear Feet 250

Trench Width 36" Max. Trench Bottom Depth 36 DVST Gravel Depth 12"

☒ ~~New System~~ ☐ Repair ☐ Expansion System Type I ☒ III IV V VI

System Description: Conventional Gravity

Repair System Description: 25% Gravity

Maintenance Agreement Required ☐ YES ☒ NO

☒ GRAVITY ☐ PRESSURE

☒ Residence No. Bedrooms 3

☐ Business No. Persons 6

☐ Other No. Employees

☐ Slab ☒ Crawl Space

☐ Basement w/plumbing ☐ Basement w/o plumbing


Water Supply: ☒ Private ☐ Public ☐ Community

Comments / Conditions


New Mobile Home to go in same place as old Mobile Home

Comments / Conditions

INITIAL SITE SKETCH

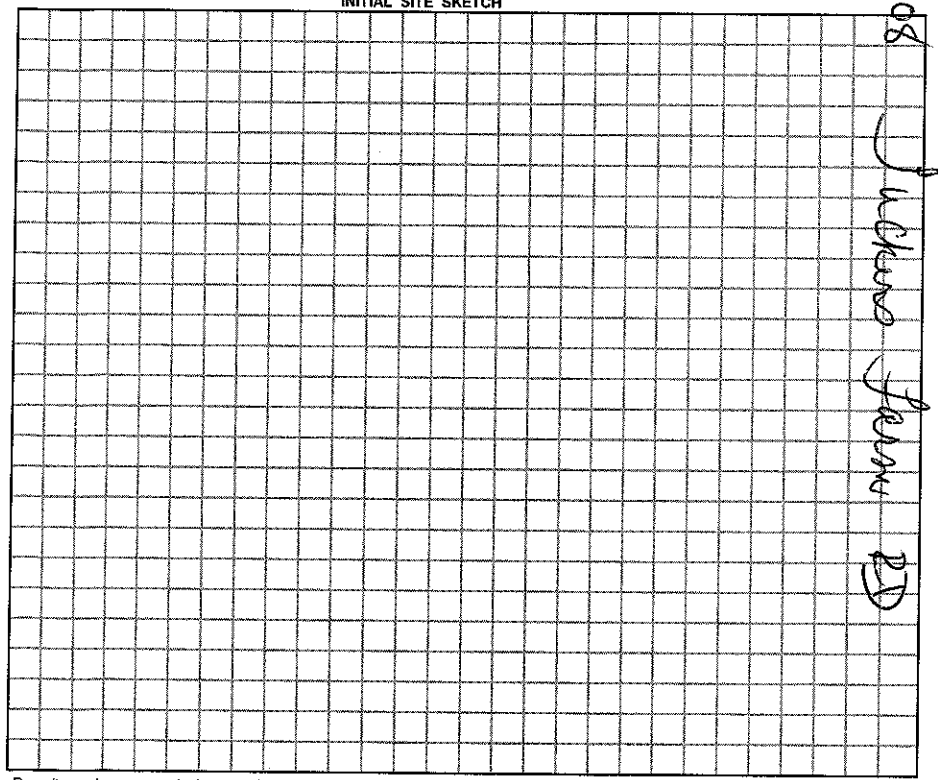

AS BUILT SKETCH

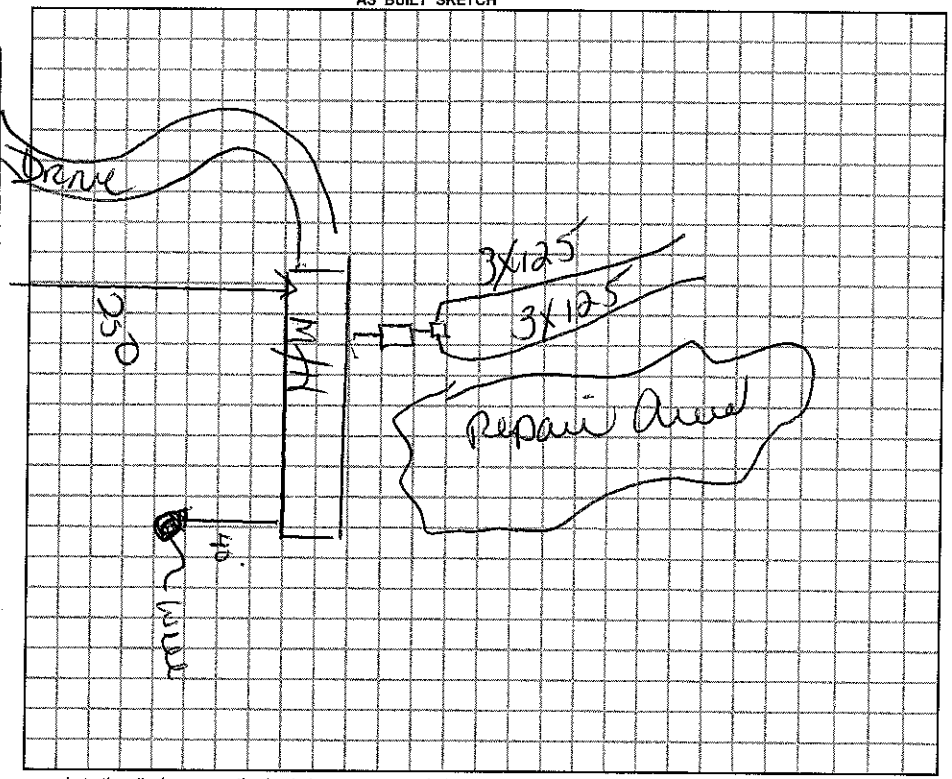

Permit can be suspended or revoked if any false information is supplied toward securing the permit / any unauthorized changes are made to the site / any unauthorized changes are made in the installation of the system.

☐ *IMPROVEMENT PERMIT w / plat valid without expiration.* ☐ *IMPROVEMENT PERMIT w / site plan valid for 60 mos.* ☒ *AUTHORIZATION TO CONSTRUCT valid for period equal to IMPROVEMENT PERMIT-not to exceed 60 mo.*

Owner / Applicant Signature: _____ Date _____

Improvement Permit by: _____ Date _____

Authorzation to Construct by: _____ Date _____

YOU SHOULD CONTACT A LOCATOR SERVICE PRIOR TO ANY EXCAVATION.

Installed by: _____

Operation Permit by: _____ Date: _____

Existing System Inspected by: Leigh Cook Date: 11-3-09

WHITE COPY Environmental Health YELLOW COPY (Final) Owner / Applicant PINK COPY (Initial) Owner / Applicant