This drawing replaces drawing issued 12-30-05

IREDELL COUNTY HEALTH DEPARTMENT

STATESVILLE 704-878-5305 CI MOORESVILLE 704-664-5281

IMPROVEMENT PERMIT / AUTHORIZATION TO CONSTRUCT / OPERATION PERMIT / EXISTING SYSTEM INSPECTION

PERMIT# 132749 PIN# 4820980701 DATE 4-18-06

OWNER OR CONTRACTOR Barry Elliot PHONE: Business 706 876 4514 Home

ADDRESS Tuckers Grove

LOCATION Hwy 115 N (R) on Tuckers Grove Rd ~1.5 miles on (R)

SUBDIVISION n/a BLOCK / SECTION LOT LOT AREA 9.903 Ac. SITE CLASS PS DESIGN FLOW 600 L.T.A.R. .4

Septic Tank: 1500 1000 Gallons; STB 1007 Date 3-28-06
Pump Tank: Gallons; PT Date
Pump Make: Model Serial No.
Nitrification Field: No Fields 1 Square Feet 1500 Linear Feet 375
No Lines 4 Trench Width 3' Max Trench Bottom Depth 36" Gravel Depth n/a

[X] New System [ ] Repair System Type: I, II, III, IV, V, VI
System Description: 25% Reduction Gravity
Repair System Description: 25% Reduction
Maintenance Agreement Required: [ ] Yes [X] No

[X] House/Mod. Home No. Bedrooms 5
[ ] Mobile Home No. Bathrooms
[ ] Business No. Employees
[ ] Other


[ ] Slab [ ] Crawl Space [X] Basement w/plumbing [ ] Basement wo/plumbing

Water Supply: [X] Individual [ ] Public [ ] Community

Comments:/Conditions:

Comments:/Conditions:

INITIAL SITE SKETCH

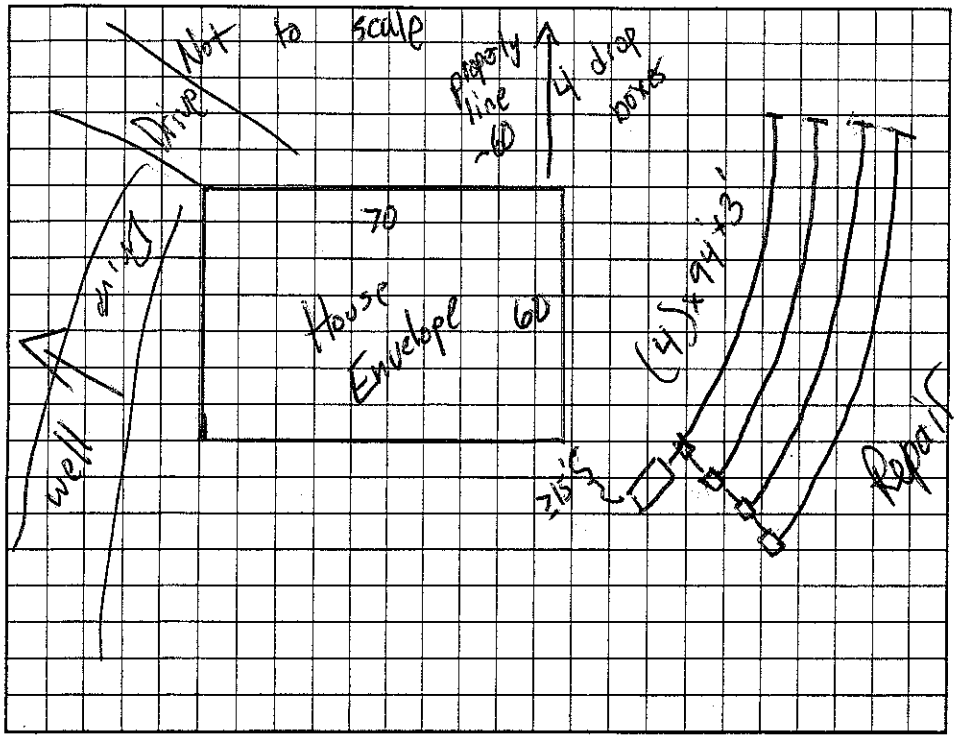

AS BUILT SKETCH

94 panels

Permit can be suspended or revoked if any false information is supplied toward securing the permit/any unauthorized changes are made to the site/any unauthorized changes are made in the installation of the system. Improvement Permit with plat valid without expiration. Improvement Permit with site plan valid for sixty months. Authorization to Construct is valid for a period equal to that of Improvement Permit – not to exceed sixty months.

Signed: Barry M Elliott date 4-18-06 Installed by: James Hoadles

Improvement Permit by: date 4-18-06 Operation Permit by: date 5-23-08

Authorization to Construct by: date 4-18-06 Existing System Inspection by: date

HEALTH DEPT. COPY: WHITE OWNER COPY (FINAL): YELLOW OWNER COPY (INITIAL): PINK