IREDELL COUNTY HEALTH DEPARTMENT

STATESVILLE 704-878-5305 MOORESVILLE 704-664-5281

IMPROVEMENT PERMIT / AUTHORIZATION TO CONSTRUCT / OPERATION PERMIT / EXISTING SYSTEM INSPECTION

PERMIT# 125649 PIN# 4821-00-5741 DATE 1/19/05

OWNER OR CONTRACTOR JOHN W. WILLIAMS PHONE: Business (704) 902-0733 Home

ADDRESS 220 CROSS COUNTRY RD. STATESVILLE NC 28625

LOCATION HWY 115N TL CROSS COUNTRY 3RD DRIVEWAY ON RIGHT

SUBDIVISION John Williams BLOCK / SECTION LOT 1 LOT AREA 12.08 SITE CLASS. P5 DESIGN FLOW 360 L.T.A.R. 0.30 gpd/ft²

Septic Tank: 1000 Gallons; STB 1007 Date 5-17-05
Pump Tank: Gallons; PT Date
Pump Make: Model Serial No.
Nitrification Field: No Fields 1 Square Feet 1200 Linear Feet 300
No Lines 3 Trench Width 36" Max Trench Bottom Depth 22" Gravel Depth N/A

☑ New System ☐ Repair System Type: I, II, III, IV, V, VI
System Description: GRAVITY 25% REDUCTION
Repair System Description: PUMP 25% REDUCTION
Maintenance Agreement Required: ☐ Yes ☑ No


☑ House/Mod. Home No. Bedrooms 3
☐ Mobile Home No. Bathrooms
☐ Business No. Employees
☐ Other
☐ Slab ☐ Crawl Space ☑ Basement w/plumbing ☐ Basement wo/plumbing

Water Supply: ☑ Individual ☐ Public ☐ Community


Comments:/Conditions: ① INSTALL 22" ON CONTOUR ② MAINTAIN SETBACKS ③ PACK & FILL DRAINAGE DITCH ④ RELOCATE DRAINAGE DITCH DOWN HILL & DIVERT WATER UNDER DRIVE

Comments:/Conditions: ① QUICK 4 STDW H 10 CHAMBER ② TANK W/ "LABEL" FILTER / NO MARKER < 6" BELOW GRADE

1"=100' 471' INITIAL SITE SKETCH

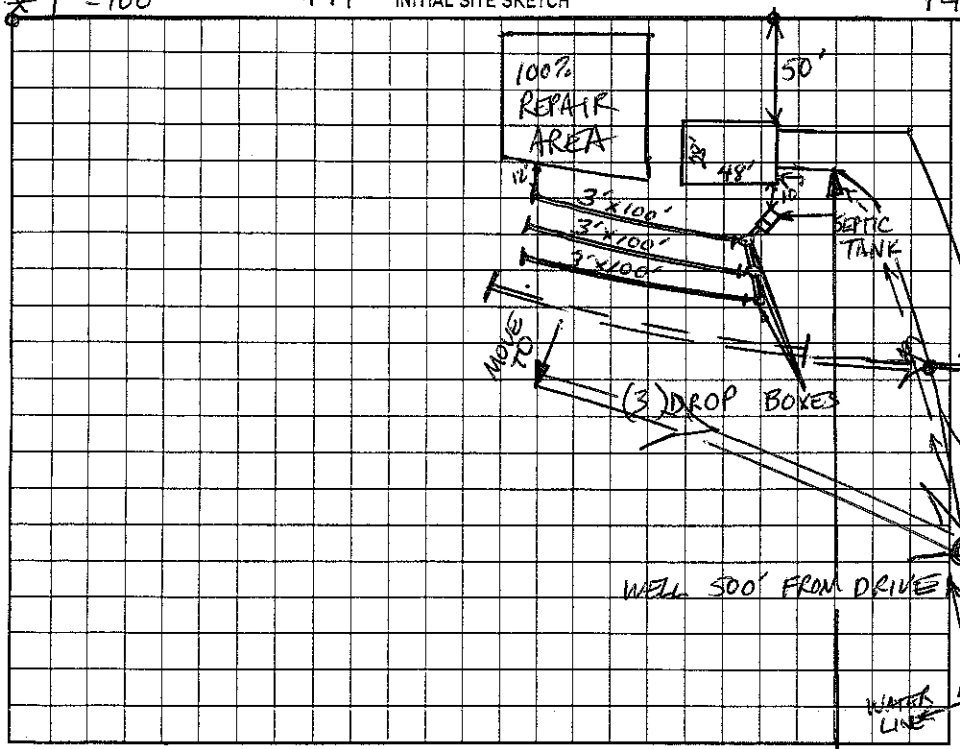

149' AS BUILT SKETCH

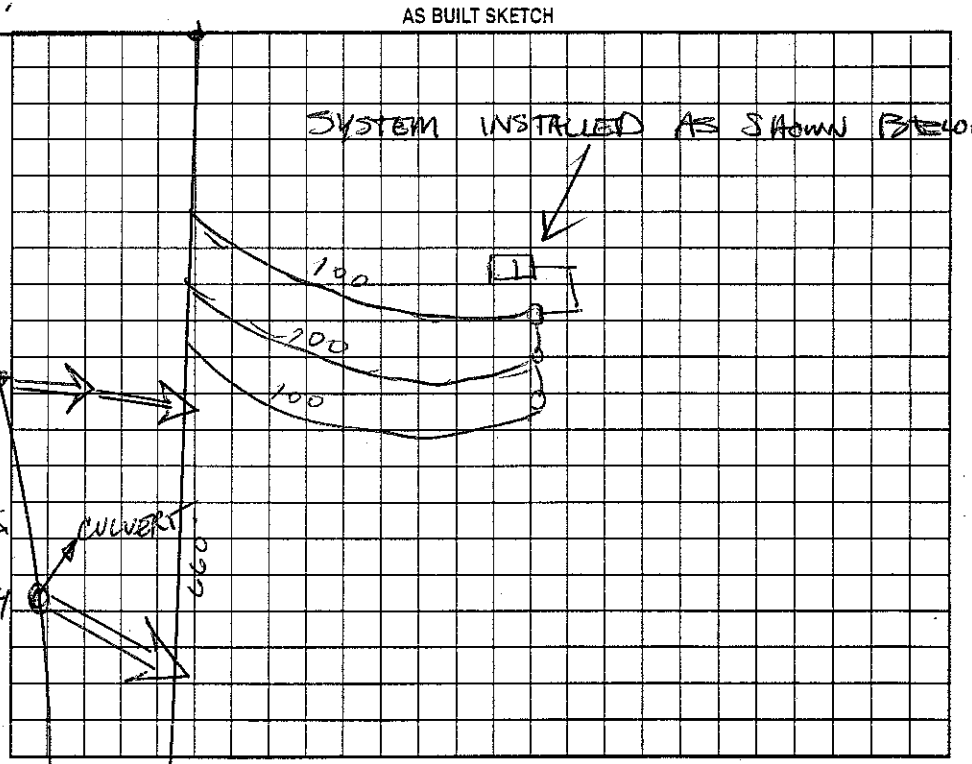

Permit can be suspended or revoked if any false information is supplied toward securing the permit/any unauthorized changes are made to the site/any unauthorized changes are made in the installation of the system. Improvement Permit with plat valid without expiration. Improvement Permit with site plan valid for sixty months. Authorization to Construct is valid for a period equal to that of Improvement Permit – not to exceed sixty months.

Signed: John W Williams Jr. date

Installed by: KENNY MADISON

Improvement Permit by: Christopher M. Shearin RS CSS date 1-19-05

Operation Permit by: Christopher M. Shearin RS CSS date 7-5-05

Authorization to Construct by: Christopher M. Shearin RS CSS date 1-19-05

Existing System Inspection by: date

HEALTH DEPT. COPY: WHITE OWNER COPY (FINAL): YELLOW OWNER COPY (INITIAL): PINK