IREDELL COUNTY HEALTH DEPARTMENT - *ENVIRONMENTAL HEALTH* ☒ STATESVILLE OFFICE 704-878-5305 ☐ MOORESVILLE OFFICE 704-664-5281

IMPROVEMENT PERMIT / AUTHORIZATION TO CONSTRUCT (A) / OPERATION PERMIT (O) / EXISTING SYSTEM INSPECTION

PERMIT # 168210 PIN # 4821-01-7509 DATE 9-9-2011

OWNER Rene Hutchings APPLICANT: PHONE: Home/Cell # (417) 291-0531 Business #

SITE ADDRESS 261 Isaac Rd. Statesville OWNER / APPLICANT ADDRESS

SITE DIRECTIONS 115 N TL Isaac Rd. 0.8 mile on left.

SUBDIVISION BLOCK / SECTION LOT # LOT AREA 10 ac. DESIGN FLOW 360 g/d L.T.A.R. 0.3 g/Ft²/d

Septic Tank 1000 Gallons: STB 760 Date 6-11 ☑ New System ☐ Repair ☐ Expansion System Type I II (III) IV V VI ☑ Residence No. Bedrooms 3 Water Supply ☑ Private - exist. *

Pump Tank Gallons: P T Date ☐ Business No. Persons 2 ☐ Public

Pump Make Model Serial # System Description: 2540 Reduction System. ☐ Other No. Employees ☐ Community

No. Nitrification Fields: 1 No. Lines 4 Linear Feet 300 Repair System Description: LPP 5070 Reduction Syst. ☐ Slab ☑ Crawl Space


Trench Width 36" Max. Trench Bottom Depth 36" Gravel Depth NA Maintenance Agreement Required ☐ YES ☐ NO ☐ Basement w/plumbing ☐ Basement w/o plumbing

☑ GRAVITY ☐ PRESSURE

Comments / Conditions Honor all setback requirements.

* Existing well located > 100' on adjacent lot.

INITIAL SITE SKETCH

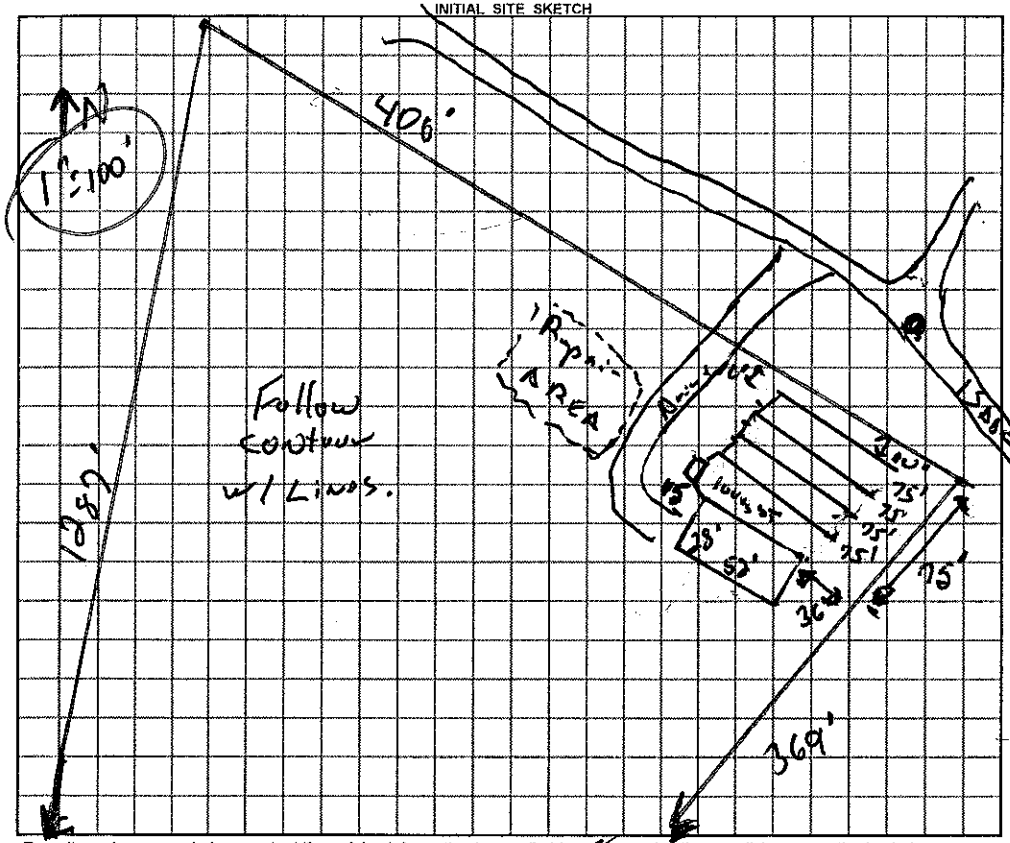

AS BUILT SKETCH

Installed as Drawn.

Permit can be suspended or revoked if any false information is supplied toward securing the permit / any unauthorized changes are made to the site / any unauthorized changes are made in the installation of the system.

☐ *IMPROVEMENT PERMIT with plat valid without expiration* ☑ *IMPROVEMENT PERMIT with plat valid without expiration.* site plan valid 60 mo. ☑ *AUTHORIZATION TO CONSTRUCT* valid for period equal to IMPROVEMENT PERMIT--not to exceed 60 mo.

Owner / Applicant Signature: Rene H. Hutchings Date 9-13-11 Installed by: A-1 Backhoe

IMPROVEMENT PERMIT by: REHS Date 9 Sept. 11 OPERATION PERMIT by: REHS Date 6 Oct 11

AUTHORIZATION TO CONSTRUCT by: REHS Date 9 Sept. 11 Existing System Inspected by: REHS Date

YOU SHOULD CONTACT A LOCATOR SERVICE PRIOR TO ANY EXCAVATION

White Copy – Environmental Health YELLOW COPY (Final) Owner / Applicant PINK COPY (Initial) Owner / Applicant