IREDELL COUNTY HEALTH DEPARTMENT

STATESVILLE 704-878-5305 MOORESVILLE 704-664-5281 (21)

IMPROVEMENT PERMIT / AUTHORIZATION TO CONSTRUCT / OPERATION PERMIT / EXISTING SYSTEM INSPECTION

PERMIT# 143032 PIN# 4821-11-5138 DATE 6-6-07

OWNER OR APPLICANT MICHAEL OCHS PHONE: Business Home 704-876-1726

ADDRESS 211 ISAAC ROAD STATESVILLE, NC 28625

LOCATION NC 115 NORTH, TL ISAAC ROAD, 0.4 MILE ON LEFT AT BOX #211

SUBDIVISION BLOCK / SECTION LOT LOT AREA 10.89 ACRES SITE CLASS. PS DESIGN FLOW 360 L.T.A.R. 0.50 GPD/FT²

Septic Tank: 1000 Gallons; STB Date

Pump Tank: Gallons; PT Date

Pump Make: Model Serial No.

Nitrification Field: No Fields Square Feet 720 Linear Feet 240

No Lines TWO Trench Width 36" Max Trench Bottom Depth Gravel Depth 12

☐ New System ☐ Repair ☐ Expansion System Type: I II III IV V VI

System Description: CONVENTIONAL, GRAVITY

Repair System Description:

Maintenance Agreement Required: ☐ Yes ☒ No

☐ Gravity ☐ Pressure ☒ Slab ☐ Crawl Space ☐ Basement w/plumbing ☐ Basement wo/plumbing

☐ House/Mod. Home ☒ Mobile Home ☐ Business ☐ Other


No. Bedrooms 3 No. Persons No. Employees

Water Supply: ☒ Individual ☐ Public ☐ Community WELL


Comments:/Conditions:

Comments:/Conditions: ① EXISTING S/W MH TO BE REMOVED UPON OCCUPANCY OF D/W MH ② SYSTEM UNDERSIZED ACCORDING TO TODAY'S STANDARDS

INITIAL SITE SKETCH

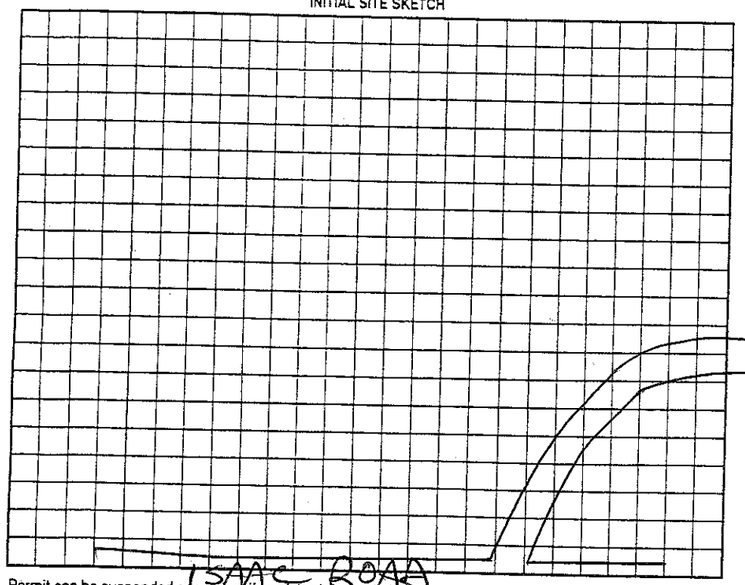

AS BUILT SKETCH

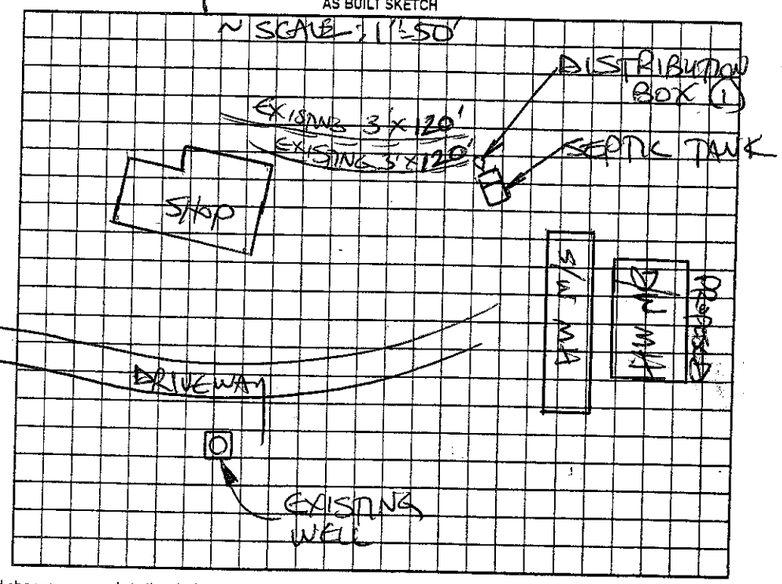

Permit can be suspended or revoked if any false information is supplied toward securing the permit/any unauthorized changes are made to the site/any unauthorized changes are made in the installation of the system. Improvement Permit with plat valid without expiration ☐ Improvement Permit with site plan valid for sixty months ☐ Authorization to Construct is valid for a period equal to that of Improvement Permit – not to exceed sixty months.

Signed: date Installed by:

Improvement Permit by: date Operation Permit by: date

Authorization to Construct by: date Existing System Inspection by: STEVE HENDRICK date 6-6-07

HEALTH DEPT. COPY: WHITE OWNER COPY (FINAL): YELLOW OWNER COPY (INITIAL): PINK