IREDELL COUNTY HEALTH DEPARTMENT

STATESVILLE 704-878-5305 MOORESVILLE 704-664-5281

IMPROVEMENT PERMIT / AUTHORIZATION TO CONSTRUCT / OPERATION PERMIT / EXISTING SYSTEM INSPECTION

PERMIT# 074502 PIN# 4821 11 9584

OWNER OR CONTRACTOR JESSIE & BAR DUNFORD PHONE: Business Home 876-6610 DATE 7-9-98

ADDRESS 165 ISAAC ROAD, STATESVILLE, NC 28677

LOCATION NC 115 N, TL ISAAC ROAD, ON RIGHT AT PAVEMENT END

SUBDIVISION BLOCK / SECTION LOT LOT AREA 1.50 ACRES SITE CLASS. PS DESIGN FLOW 360 L.T.A.R. 0.30 GPD/FT2

Septic Tank: 1000 Gallons; STB 1017 Date 5-12-98

Pump Tank: Gallons; PT Date

Pump Make: Model Serial No.

Nitrification Field: No Fields 1 Square Feet 50 TO 1200 Linear Feet 300+

No Lines FOUR Trench Width 36" Max Trench Bottom Depth 36"

☑ New System ☐ Repair System Type: I, II, (III) IV, V, VI

System Description: 25% REDUCTION - GRAVITY

Repair System Description: 25% REDUCTION - GRAVITY

Maintenance Agreement Required: ☐ Yes ☑ No

~~Gravel~~ Depth SAND 6"

☐ House/Mod. Home ☑ Mobile Home ☐ Business ☐ Other

No. Bedrooms 3 No. Bathrooms 2 No. Employees


☐ Slab ☑ Crawl Space ☐ Basement w/plumbing ☐ Basement wo/plumbing

Water Supply: ☑ Individual ☐ Public ☐ Community WELL


Comments:/Conditions: ① NO VEHICULAR TRAFFIC ALLOWED OVER SYSTEM ② INSTALL 300 FEET + 25% REDUCTION SYSTEM IN LINES ON CONTOUR AS SHOWN ③ USE FOUR (4) DROP BOXES FOR SERIAL DISTRIBUTION

Comments:/Conditions:

INITIAL SITE SKETCH SCALE: 1"=50'

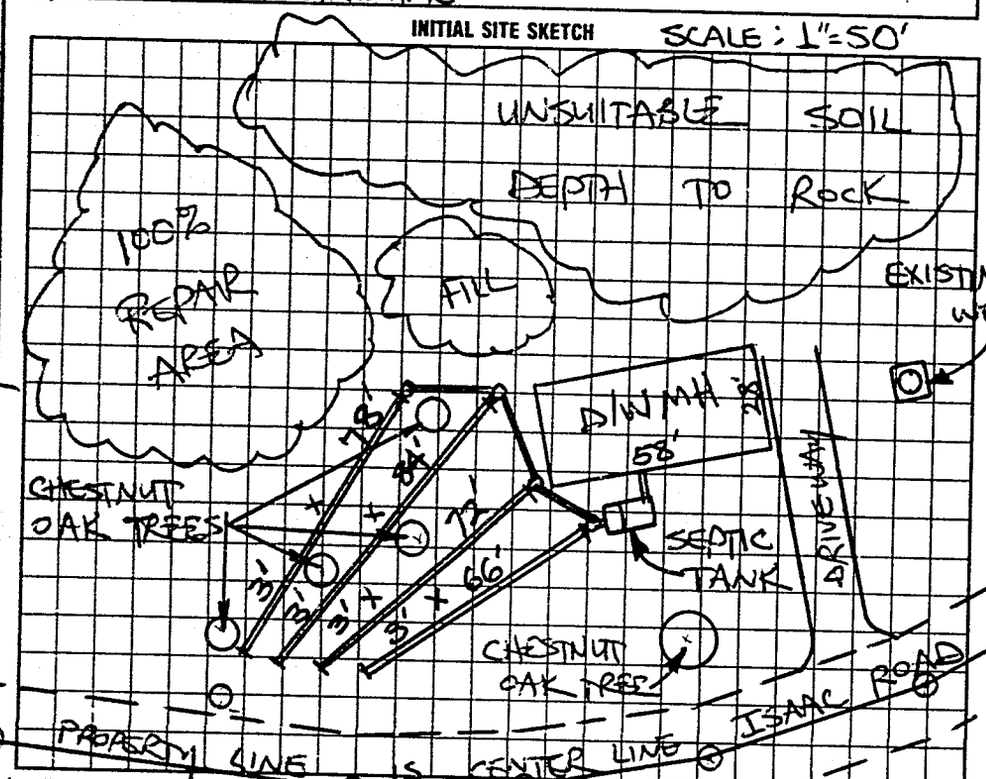

AS BUILT SKETCH

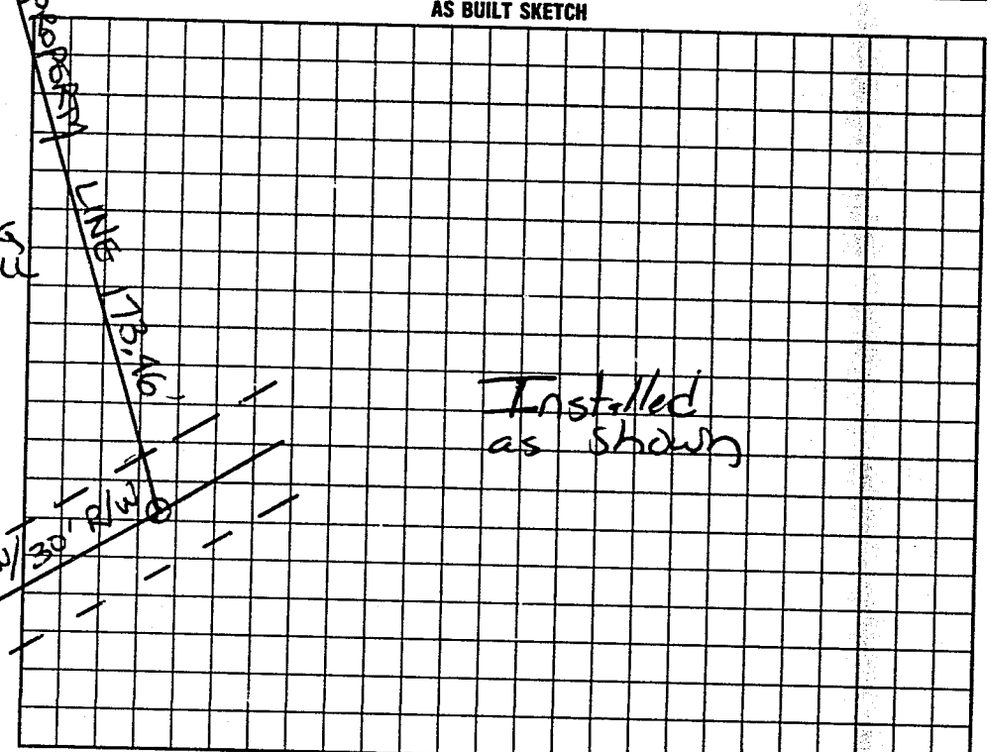

I understand that this permit can be suspended or revoked if any false information is supplied toward securing the permit/any unauthorized changes are made to the site/any unauthorized changes are made in the installation of the system. Improvement Permit with plat valid without expiration. Improvement Permit with site plan valid for sixty months. Authorization to Construct is valid for a period equal to that of Improvement Permit – not to exceed sixty months.

Signed: Dennis Gallihar date 7-13-98

Improvement Permit by: STEVE HEDRICK date 7-9-98

Authorization to Construct by: STEVE HEDRICK date 7-9-98

Installed by: A-1 Backhoe

Operation Permit by: Mat Cofer date 7-17-98

Existing System Inspection by: date

HEALTH DEPT COPY WHITE INSPECTION COPY (FINAL) GREEN OWNER COPY (FINAL) YELLOW INSPECTION COPY (INITIAL) PINK OWNER COPY (INITIAL) GOLD