IREDELL COUNTY HEALTH DEPARTMENT

STATESVILLE 704-878-5305 MOORESVILLE 704-664-5281

IMPROVEMENT PERMIT / AUTHORIZATION TO CONSTRUCT / OPERATION PERMIT / EXISTING SYSTEM INSPECTION

PERMIT# REPAIR PIN#

OWNER OR CONTRACTOR ROGER BARNETTE PHONE: Business Home 592-4902 DATE 1-19-99

ADDRESS 241 CARDERWOODY ROAD STATESVILLE NC 28625

LOCATION NC 115 N TO CARDERWOODY ROAD, 0.5 MILE ON LEFT AT BOX # 241

SUBDIVISION BLOCK / SECTION LOT LOT AREA AMPLE SITE CLASS. PS DESIGN FLOW 360 L.T.A.R. EXISTING

Septic Tank: 1000 Gallons; STB 794 Date 12-6-98

Pump Tank: Gallons; PT Date

Pump Make: Model Serial No.

Nitrification Field: No Fields 1 Square Feet Linear Feet EXISTING

No Lines EXISTING Trench Width Max Trench Bottom Depth Gravel Depth

☐ New System ☑ Repair System Type: I (II) III, IV, V, VI

System Description:

Repair System Description: CONV. GRAVITY

Maintenance Agreement Required: ☐ Yes ☑ No

☐ Slab ☐ Crawl Space ☑ Basement w/plumbing ☐ Basement wo/plumbing

☑ House/Mod. Home No. Bedrooms 3

☐ Mobile Home No. Bathrooms 2

☐ Business No. Employees


☐ Other

Water Supply: ☑ Individual ☐ Public ☐ Community WELL

Comments:/Conditions: [illegible]

Comments:/Conditions: W/ POLYLOCK FILTER AT OUTLET

INITIAL SITE SKETCH

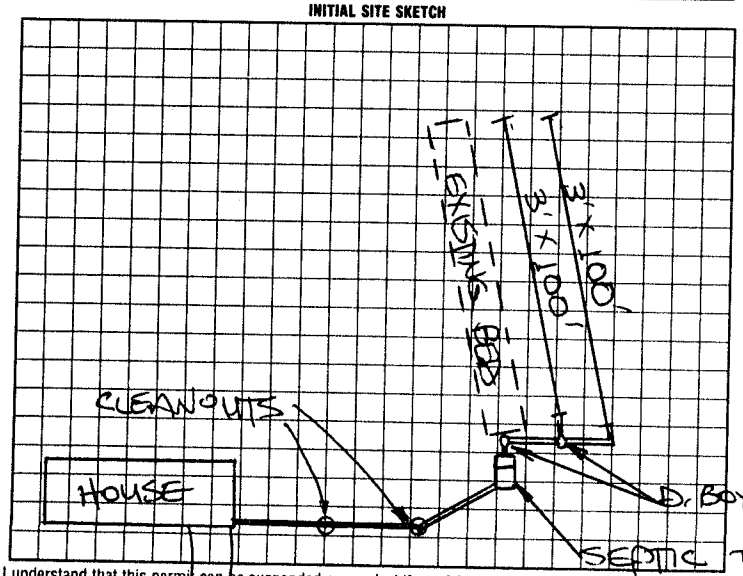

AS BUILT SKETCH

SEPTIC TANK REPLACED ACCORDING TO INITAL SITE SKETCH

I understand that this permit can be suspended or revoked if any false information is supplied toward securing the permit/any unauthorized changes are made to the site/any unauthorized changes are made in the installation of the system. Improvement Permit with plat valid without expiration. Improvement Permit with site plan valid for sixty months. Authorization to Construct is valid for a period equal to that of Improvement Permit – not to exceed sixty months.

Signed: Roger Barnette date 1 19 99

Improvement Permit by: STEVE HEDRICK date 1-19-99

Authorization to Construct by: STEVE HEDRICK date 1-19-99

Installed by: WES LYTTON

Operation Permit by: STEVE HEDRICK date 1-19-99

Existing System Inspection by: date

HEALTH DEPT. COPY: WHITE INSPECTION COPY (FINAL): GREEN OWNER COPY (FINAL): YELLOW INSPECTION COPY (INITIAL): PINK OWNER COPY (INITIAL): GOLD