IREDELL COUNTY HEALTH DEPARTMENT

STATESVILLE 704-878-5305 MOORESVILLE 704-664-5281

IMPROVEMENT PERMIT / CERTIFICATE OF COMPLETION / OPERATION PERMIT / EXISTING SYSTEM INSPECTION

PROPERTY DESCRIPTION NO. 16847 DATE 8/23/93 TAX MAP NO. 15B-A-15

OWNER OR CONTRACTOR W. STANLEY BIRCH PHONE: Business Home (704) 872-5244

ADDRESS RT. 11, BOX 272-A STATESVILLE, NC 28677

LOCATION NC 115 N, TL 'CARDERWOODY' ROAD, ON (R) JUST BEFORE CREEK,

SUBDIVISION BLOCK / SECTION LOT LOT AREA 4.8274 SITE CLASS. PS L.T.A.R. 0.336 GPD/FT²

Water Supply: ☑ Individual ☐ Community ☐ Public SPRING

Septic Tank: 1000 Gallons: STB 792 Date 5/18/94

Pump Tank: Gallons: PT Date

Nitrification Field: No Fields 1 Square Feet 1080 Linear Feet 360

No Lines 3 Trench Width 36" Trench Depth 18-30 Gravel Depth 12"

☑ New System ☐ Repair System Type: I, II, III, IV, V, VI

System Description: CONV. GRAVITY

Repair System Description: CONV. GRAVITY

Maintenance Agreement Required: ☐ Yes ☑ No

☐ House/Mod. Home ☑ FUTURE Mobile Home ☐ Business ☐ Other PLANNED FOR FUTURE 3BR

No. Bedrooms 3 No. Bathrooms 2 No. Employees

☐ Slab ☑ Crawl Space ☐ Basement w/plumbing ☐ Basement wo/plumbing

Garbage Disposal: ☐ Yes ☑ No


Auto. Dishwasher: ☑ Yes ☐ No

Auto. Washing Machine: ☑ Yes ☐ No


Other

Comments ① KEEP SYSTEM MINIMUM 5' FROM M.H & FUTURE HOUSE SITE, 10' FROM PROPERTY LINE, 100' FROM SPRING ② INSTALL LINES ON CONTOUR, NO DEEPER THAN 30" 9' APART ON CENTER ③ MH TO BE REMOVED UPON OCCUPANCY OF HOUSE.

INITIAL SITE SKETCH

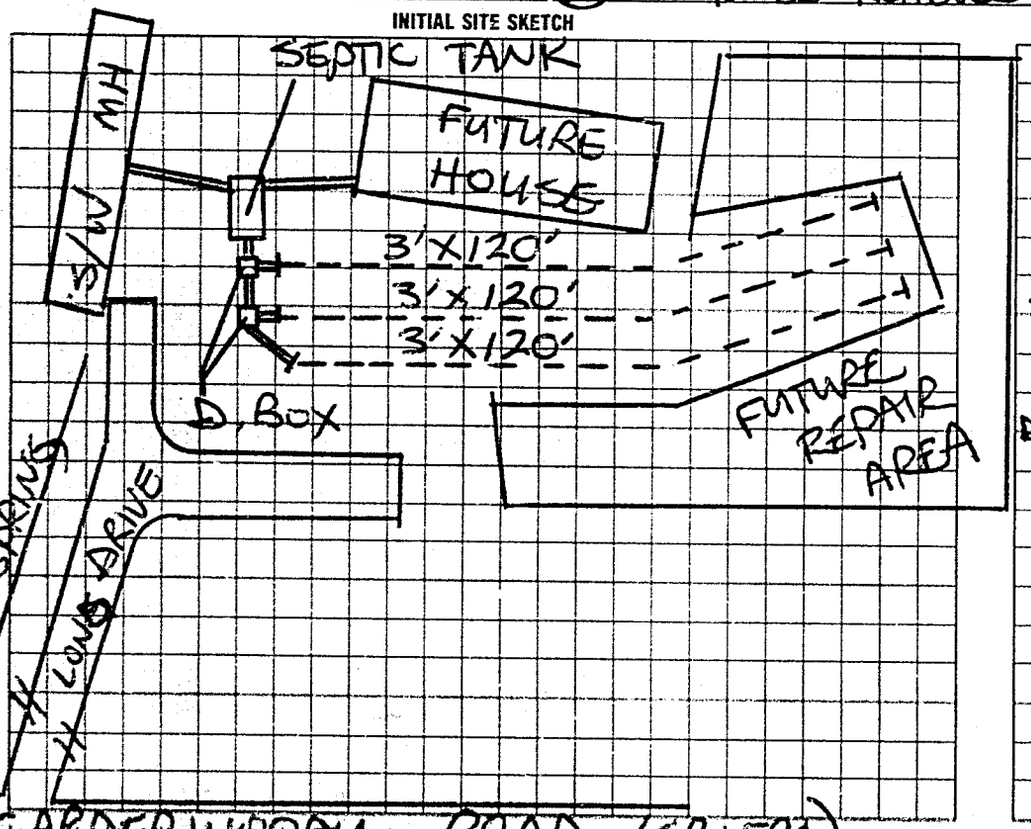

AS BUILT SKETCH

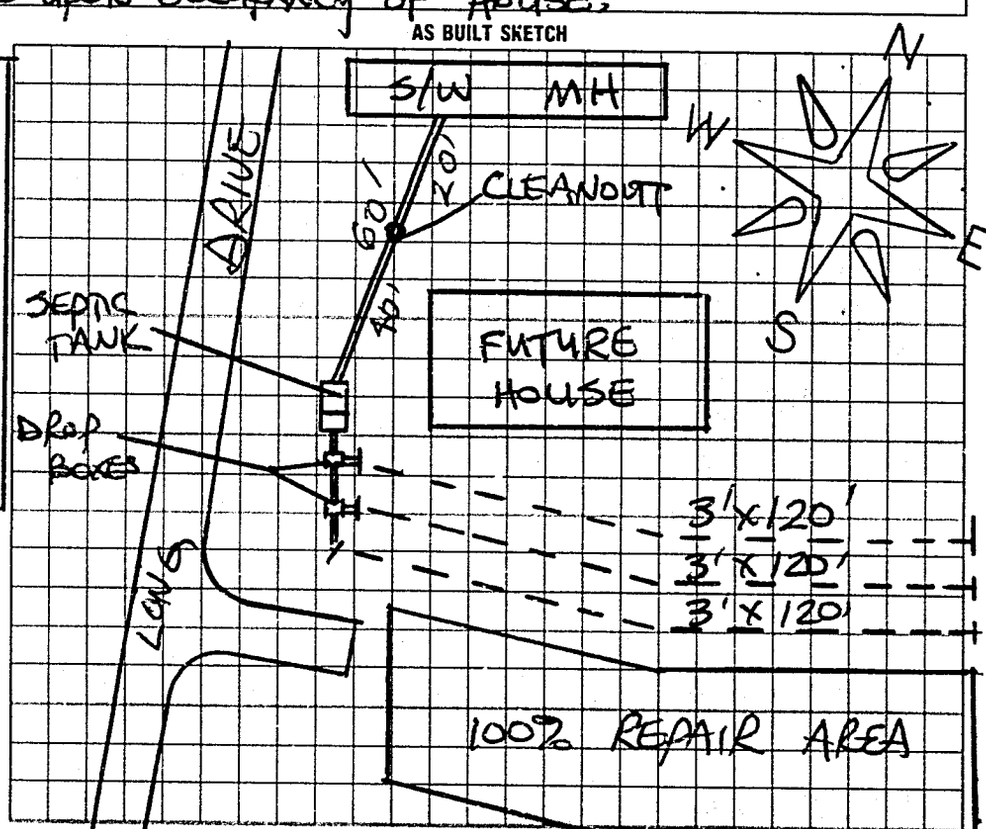

I understand that this permit can be suspended or revoked if any false information is supplied toward securing the permit/any unauthorized changes are made to the site/any unauthorized changes are made in the installation of the system. Improvement Permit is valid for 60 months from date of issuance.

Signed: X W. Stanley Birch

Improvement Permit by: STEVE HEDRICK date 8/23/93

Existing System Inspection by: date

Installed by: A-1 BACKHOE

Certificate of Completion by: STEVE HEDRICK date 6/28/94

Operation Permit by: date

HEALTH DEPT. COPY: WHITE INSPECTION COPY (FINAL): GREEN OWNER COPY (FINAL): YELLOW INSPECTION COPY (INITIAL): PINK OWNER COPY (INITIAL): GOLD