IREDELL COUNTY HEALTH DEPARTMENT

Statesville Phone TR 3-7271 Mooresville Phone NO 3-1271

PERMIT TO INSTALL SEPTIC TANK

Permit NO. 70 Permit Date DEC. 8 1970

Owner FRIENDLY CHAPEL CHURCH Address RT. 2. STATESVILLE, N.C.

Installed By JAMES HARTNESS Address RT. 1. UNION GROVE, N.C.


Location of Property 11.5 NORTH - TURN LEFT AT CHURCH SIGN 4.8/10 ABOVE CENTRAL SCHOOL. ROAD #1626

Tank		Capacity		Length of Lines		Fixtures	
Block	( )	1000	(✓)	225'	(✓)	No. of Baths	(2)
Precast	(✓)	1250	( )	250'	( )	Dishwasher	( )
		1500	( )	Other		Garbage Grdr.	( )
		Other				Other	

NOTIFY HEALTH DEPARTMENT AT LEAST EIGHT HOURS BEFORE TANK IS TO BE INSPECTED.

Final Inspection DEC. 8 1970 Approved (✓) Disapproved ( )

Remarks

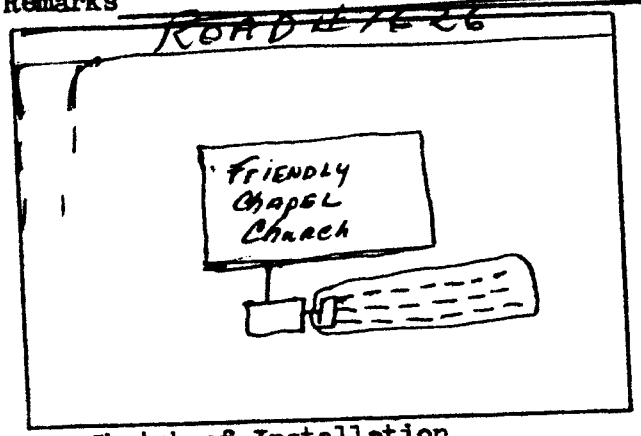

Sketch of Installation

Glenn Ford

Sanitarian