IREDELL COUNTY HEALTH DEPARTMENT

STATESVILLE 704-878-5305 MOORESVILLE 704-664-5281

IMPROVEMENT PERMIT / AUTHORIZATION TO CONSTRUCT / OPERATION PERMIT / EXISTING SYSTEM INSPECTION

PERMIT# 068888 PIN# 4821 31 1437 (PART) DATE 6-27-98

OWNER OR CONTRACTOR SHERRY W. WILCOX PHONE: Business Home 876-6012

ADDRESS 161 ISAAC ROAD, STATESVILLE, NC 28625

LOCATION NC 115 N, TL ISAAC ROAD, TL PRIVATE DRIVE AT BOX #161, OFF ROAD ~450'

SUBDIVISION BLOCK / SECTION LOT LOT AREA 0.92 ACRE SITE CLASS. PS DESIGN FLOW 360 L.T.A.R. 0.40 GPD/FT²

Septic Tank: 1000 Gallons; STB 825 Date 6-4-98

Pump Tank: Gallons; PT Date

Pump Make: Model Serial No.

Nitrification Field: No Fields 1 Square Feet 900 Linear Feet 300

No Lines FOUR Trench Width 36" Max Trench Bottom Depth 36" Gravel Depth 12"

☒ New System ☐ Repair System Type: I (II) III, IV, V, VI

System Description: CONVENTIONAL GRAVITY

Repair System Description: CONVENTIONAL GRAVITY

Maintenance Agreement Required: ☐ Yes ☒ No

☐ House/Mod. Home ☒ Mobile Home ☐ Business ☐ Other

No. Bedrooms 3 No. Bathrooms 2 No. Employees

Water Supply: ☒ Individual ☐ Public ☐ Community WELL


☐ Slab ☒ Crawl Space ☐ Basement w/plumbing ☐ Basement wo/plumbing

Comments:/Conditions: S/W MH AS SET-UP ON SITE DOES NOT MEET IREDELL COUNTY ZONING REQUIREMENTS FOR SETBACKS.

Comments:/Conditions:

SCALE: 1"=50'

INITIAL SITE SKETCH

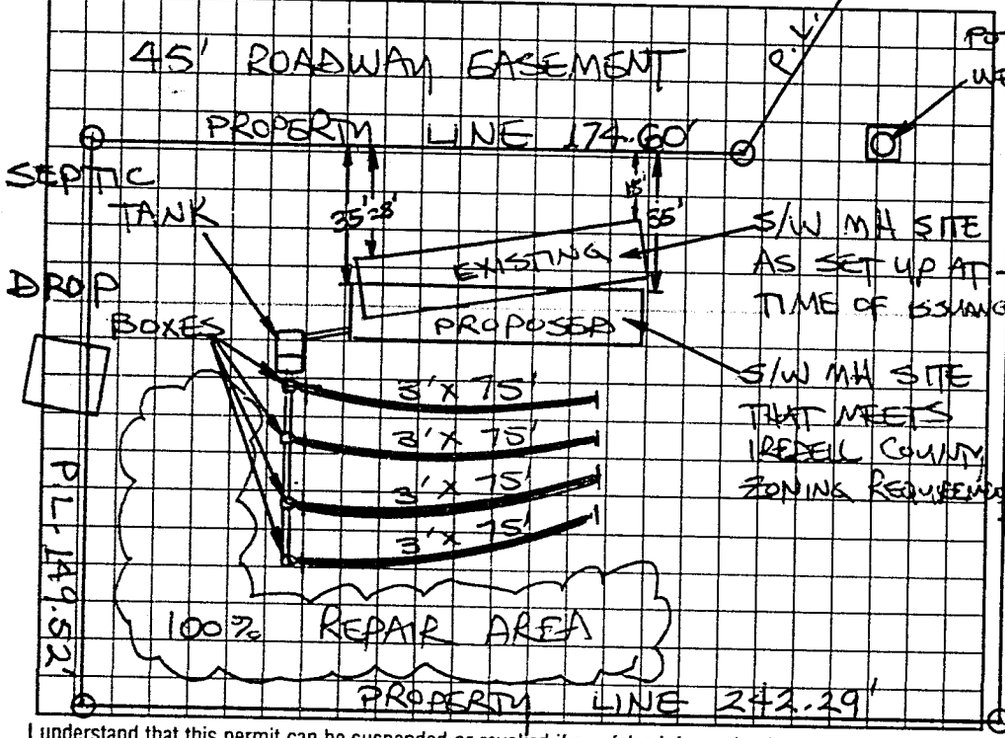

AS BUILT SKETCH

I understand that this permit can be suspended or revoked if any false information is supplied toward securing the permit/any unauthorized changes are made to the site/any unauthorized changes are made in the installation of the system. Improvement Permit with plat valid without expiration. Improvement Permit with site plan valid for sixty months. Authorization to Construct is valid for a period equal to that of Improvement Permit – not to exceed sixty months.

Signed: x Sherry Wilcox date 6-27-98

Improvement Permit by: STEVE HEDRICK date 6-27-98

Authorization to Construct by: STEVE HEDRICK date 6-27-98

Installed by: Upright Grading & Septic

Operation Permit by: [illegible] date 8-24-98

Existing System Inspection by: date

HEALTH DEPT COPY: WHITE INSPECTION COPY (FINAL): GREEN OWNER COPY (FINAL): YELLOW INSPECTION COPY (INITIAL): PINK OWNER COPY (INITIAL): GOLD

128000