IREDELL COUNTY HEALTH DEPARTMENT - *ENVIRONMENTAL HEALTH* ☒ STATESVILLE OFFICE 704-878-5305 ☐ MOORESVILLE OFFICE 704-664-5281

IMPROVEMENT PERMIT / AUTHORIZATION TO CONSTRUCT / OPERATION PERMIT / EXISTING SYSTEM INSPECTION

PERMIT # Repair PIN # 4821-05-4360 DATE 11 October 11

OWNER Clarence Sprinkle APPLICANT: Jarrod Lentz

SITE ADDRESS 5005 Hwy 115 Statesville PHONE: Home/Cell # (704) 902-4607 Business #

SITE DIRECTIONS 115 N ON Left just before Friendship ch

SUBDIVISION BLOCK / SECTION LOT # LOT AREA

Septic Tank 1000g Gallons: STB 760 Date 11-7-11 — New System ☑ Repair ☐ Expansion System Type I II III IV V VI — ☑ Residence No. Bedrooms 3 — Water Supply: ☑ Private ☐ Public ☐ Community

Pump Tank Gallons: P T Date — System Description: GTR — ☐ Business No. Persons — ☐ Other No. Employees — ☐ Slab ☒ Crawl Space — ☐ Basement w/plumbing ☐ Basement w/o plumbing


Pump Make Model Serial # — Repair System Description: TANK

No. Nitrification Fields: EX No. Lines EX Linear Feet EX — Maintenance Agreement Required ☐ YES ☑ NO

Trench Width EX Max. Trench Bottom Depth EX Gravel Depth — ☑ GRAVITY ☐ PRESSURE

Comments / Conditions: Replace exist. ST with New 1000g ST AND Connect to existing system.

INITIAL SITE SKETCH

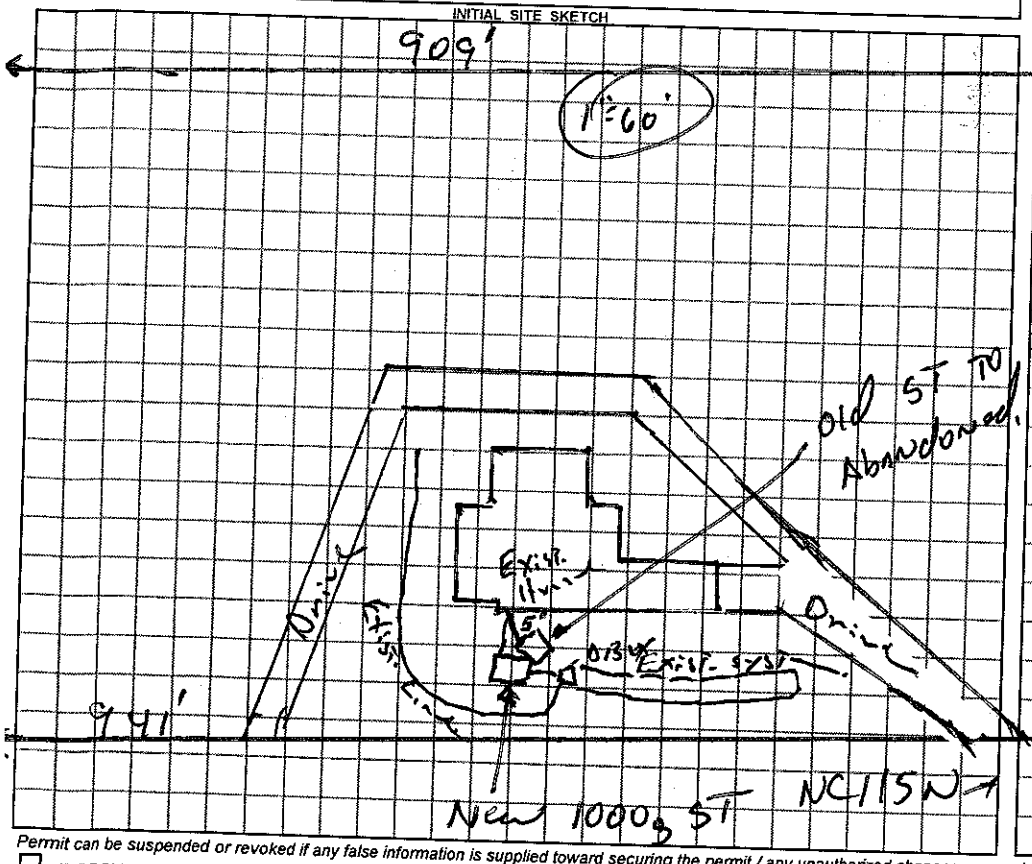

AS BUILT SKETCH

Permit can be suspended or revoked if any false information is supplied toward securing the permit / any unauthorized changes are made to the site / any unauthorized changes are made in the installation of the system.

☐ ***IMPROVEMENT PERMIT*** with plat valid without expiration. ☐ ***IMPROVEMENT PERMIT*** with plat valid without expiration. ***site plan valid 60 mo.*** ☑ ***AUTHORIZATION TO CONSTRUCT*** valid for period equal to IMPROVEMENT PERMIT–not to exceed 60 mo.

Owner / Applicant Signature: Jarrod Lentz Date 10-11-11 Installed by: Lentz Septic

IMPROVEMENT PERMIT by: REHS Date

AUTHORIZATION TO CONSTRUCT by: REHS Date 11 Oct. 11 OPERATION PERMIT by: REHS Date 10-27-11

YOU SHOULD CONTACT A LOCATOR SERVICE PRIOR TO ANY EXCAVATION Existing System Inspected by: REHS Date

White Copy – Environmental Health YELLOW COPY (Final) Owner / Applicant PINK COPY (Initial) Owner / Applicant