IREDELL COUNTY HEALTH DEPARTMENT

STATESVILLE 704-878-5305 MOORESVILLE 704-664-5281

IMPROVEMENT PERMIT / AUTHORIZATION TO CONSTRUCT / OPERATION PERMIT / EXISTING SYSTEM INSPECTION

PERMIT# 090425 PIN# 4821 41 0179 (PART) DATE 7-15-2000

OWNER OR CONTRACTOR BRENDA BELL PHONE: Business Home 546-7123

ADDRESS 145 LINDA DRIVE, HARMONY, NC 28634

LOCATION NC 115 North, TR BRUCE FARM RD, TR 1ST DRIVEWAY, MH ON LEFT

SUBDIVISION BLOCK / SECTION LOT LOT AREA 1.33 ACRES SITE CLASS PS DESIGN FLOW 360 L.T.A.R. 0.30 GPD/FT²

Septic Tank: 1000 Gallons: STB 1012 Date 6-16-00
Pump Tank: 1000 Gallons: PT 17 Date 3-14-00
Pump Make: Hydromatic Model SHEF50A Serial No. 51867008
Nitrification Field: No Fields 1 Square Feet 1200 Linear Feet 400
No Lines FIVE Trench Width 36" Max Trench Bottom Depth 30"

☑ New System ☐ Repair System Type: I II III IV V VI
System Description: CONVENTIONAL, PUMP
Repair System Description: CONV, PUMP
Maintenance Agreement Required: ☐ Yes ☑ No
Gravel Depth 12"

☐ House/Mod. Home ☑ Mobile Home ☐ Business ☐ Other
No. Bedrooms 3 No. Bathrooms 2 No. Employees


Water Supply: ☑ Individual ☐ Public ☐ Community
WELL NEXT DOOR

☐ Slab ☑ Crawl Space ☐ Basement w/plumbing ☐ Basement wo/plumbing


Comments:/Conditions:

Comments:/Conditions: 8-3- Check tank, lines set pressure - Floats need to be checked

INITIAL SITE SKETCH

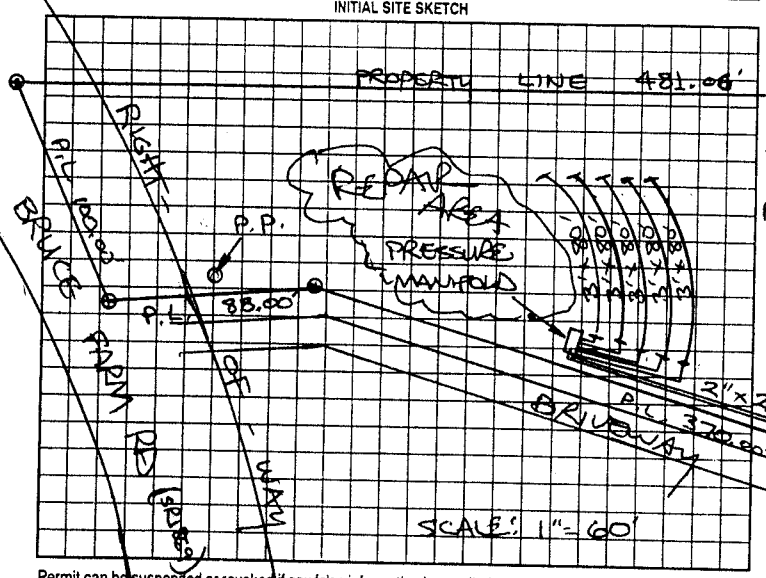

AS BUILT SKETCH

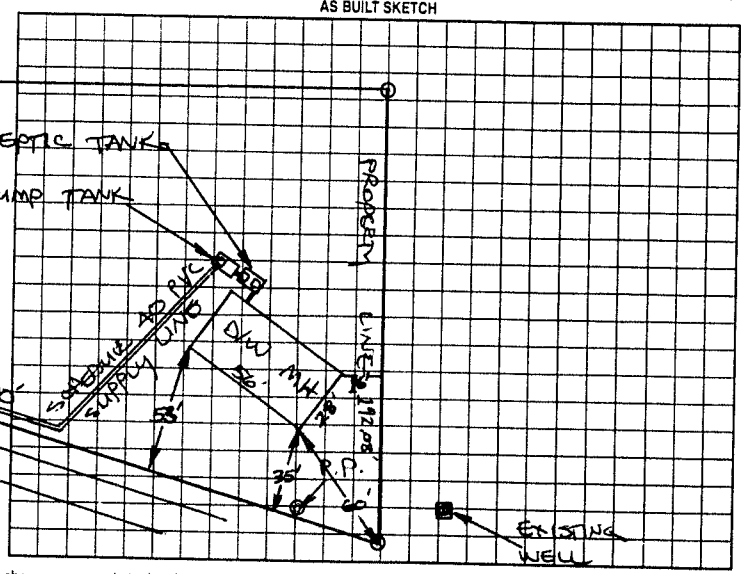

Permit can be suspended or revoked if any false information is supplied toward securing the permit/any unauthorized changes are made to the site/any unauthorized changes are made in the installation of the system. Improvement Permit with plat valid without expiration. Improvement Permit with site plan valid for sixty months. Authorization to Construct is valid for a period equal to that of Improvement Permit – not to exceed sixty months.

Signed: Bell Vann date

Installed by: A-1 Backhoe

Improvement Permit by: STEVE HEDRICK date 7-15-2000

Operation Permit by: STEVE HEDRICK date 9-6-00

Authorization to Construct by: STEVE HEDRICK date 7-15-2000

Existing System Inspection by: date

HEALTH DEPT. COPY: WHITE OWNER COPY (FINAL): YELLOW OWNER COPY (INITIAL): PINK