IREDELL COUNTY HEALTH DEPARTMENT

STATESVILLE 704-878-5305 MOORESVILLE 704-664-5281

IMPROVEMENT PERMIT / CERTIFICATE OF COMPLETION / OPERATION PERMIT / EXISTING SYSTEM INSPECTION

PROPERTY DESCRIPTION NO. 19985 DATE 1/17/95 TAX MAP NO. 14N-A-46 (PART of) Watershed: ☐ Yes ☑ No

OWNER OR CONTRACTOR DONALD C. HARMON PHONE: Business Home 876-3456

ADDRESS 652 TUCKERS GROVE ROAD, STATESVILLE NC 28677

LOCATION NC 115 N, TR BRUCE RD, TR TUCKERS GROVE ROAD, ~ 200' ON LEFT

SUBDIVISION BLOCK / SECTION LOT LOT AREA AMPLE SITE CLASS. PS1 DESIGN FLOW 240 L.T.A.R. 0.33 GAD/FT²

Septic Tank: 1000 Gallons; STB 620 Date 10/27/94

Pump Tank: Gallons; PT Date

Pump Make: Model Serial No.

Nitrification Field: No Fields 1 Square Feet 720 Linear Feet 240

No Lines 2 Trench Width 36" Max Trench Bottom Depth 18-36" Gravel Depth 12"

☑ New System ☐ Repair System Type: I, II, III, IV, V, VI

System Description: CONVENTIONAL GRAVITY

Repair System Description: CONV. GRAVITY

Maintenance Agreement Required: ☐ Yes ☑ No

☐ House/Mod. Home No. Bedrooms 2

☑ Mobile Home No. Bathrooms 2

☐ Business No. Employees

☐ Other


☐ Slab ☑ Crawl Space ☐ Basement w/plumbing ☐ Basement wo/plumbing

Water Supply: ☑ Individual ☐ Community ☐ Public WELL

Comments: ① KEEP SYSTEM MINIMUM 5' FROM MH, 10' FROM PROPERTY LINE, 50' FROM EXISTING UNUSED WELL. ② INSTALL LINES AS SHOWN ON CONTOUR NO DEEPER THAN 36" 9' APART MINIMUM ON CENTER

Comments:

INITIAL SITE SKETCH

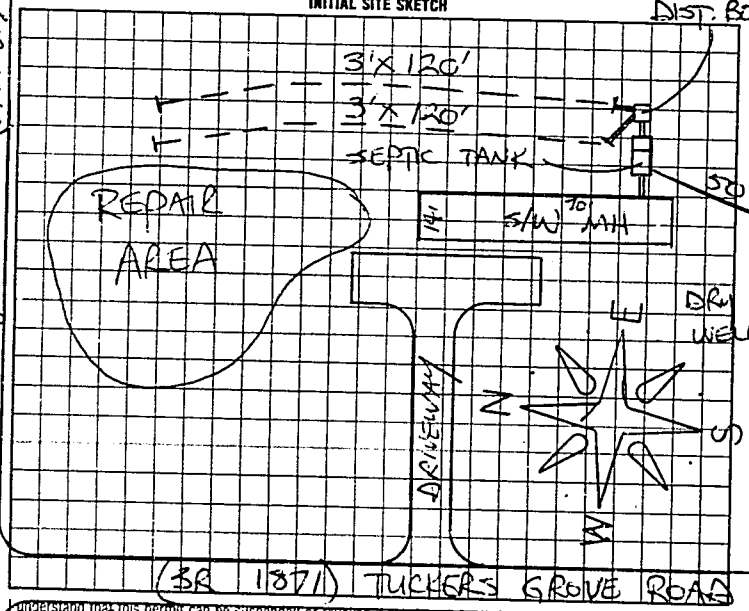

AS BUILT SKETCH

SYSTEM INSTALLED ACCORDING TO INITIAL SITE SKETCH

I understand that this permit can be suspended or revoked if any false information is supplied toward securing the permit, any unauthorized changes are made to the site/any unauthorized changes are made in the installation of the system. Improvement Permit is valid for 60 months from date of issuance.

Signed: Donald Harmon

Improvement Permit by: STEVE HEDRICK date 1/17/95

Existing System Inspection by: date

Installed by: SAMMY REAVIS

Certificate of Completion by: STEVE HEDRICK date 2/10/95

Operation Permit by: date

HEALTH DEPT. COPY: WHITE INSPECTION COPY (FINAL): GREEN OWNER COPY (FINAL): YELLOW INSPECTION COPY (INITIAL): PINK OWNER COPY (INITIAL): GOLD