IREDELL COUNTY HEALTH DEPARTMENT

STATESVILLE 704-878-5305 (c1) MOORESVILLE 704-664-5281

IMPROVEMENT PERMIT / AUTHORIZATION TO CONSTRUCT / OPERATION PERMIT / EXISTING SYSTEM INSPECTION

(d)

PERMIT# 108735 PIN# ~~4821-51-6036, 8~~ 4821-50-6629 DATE 11-6-02

OWNER OR CONTRACTOR DONALD LASHOMB PHONE: Business 704-525-0081 Home 704-588-5555

ADDRESS 16715 CAPPS ROAD, CHARLOTTE NC 28278

LOCATION NC 115 NORTH, TR TUCKERS GROVE ROAD, DN RIGHT 1ST LOT PAST ARRINGTON ROAD

SUBDIVISION BILLIE SWANSON BLOCK / SECTION ____ LOT 9 LOT AREA 3.607 ACRES SITE CLASS. PS DESIGN FLOW 360 L.T.A.R. 0.30 GPD/FT²

Septic Tank: 1000 Gallons; STB 1012 Date 5-9-04
Pump Tank: ____ Gallons; PT ____ Date ____
Pump Make: ____ Model ____ Serial No. ____
Nitrification Field: No Fields 1 Square Feet 1200 Linear Feet 400
No Lines THREE Trench Width 36" Max Trench Bottom Depth 36" Gravel Depth 12"

☑ New System ☐ Repair System Type: I (II) III, IV, V, VI
System Description: CONVENTIONAL GRAVITY
Repair System Description: CONVENTIONAL, GRAVITY
Maintenance Agreement Required: ☐ Yes ☑ No


☑ House/Mod. Home No. Bedrooms 3
☐ Mobile Home No. Bathrooms 2
☐ Business No. Employees ____
☐ Other ____
☐ Slab ☐ Crawl Space ☐ Basement w/plumbing ☑ Basement wo/plumbing

Water Supply: ☑ Individual ☐ Public ☐ Community WELL

Comments/Conditions: KEEP SYSTEM MINIMUM 100 FEET FROM WELL, 15 FEET SIDE SLOPE FROM BASEMENT

Comments/Conditions: SEPTIC TANK WITH MARKER INSTALLED ~~[illegible]~~ USING "TUFTITE" FILTER.

INITIAL SITE SKETCH SCALE: 1" = 100'

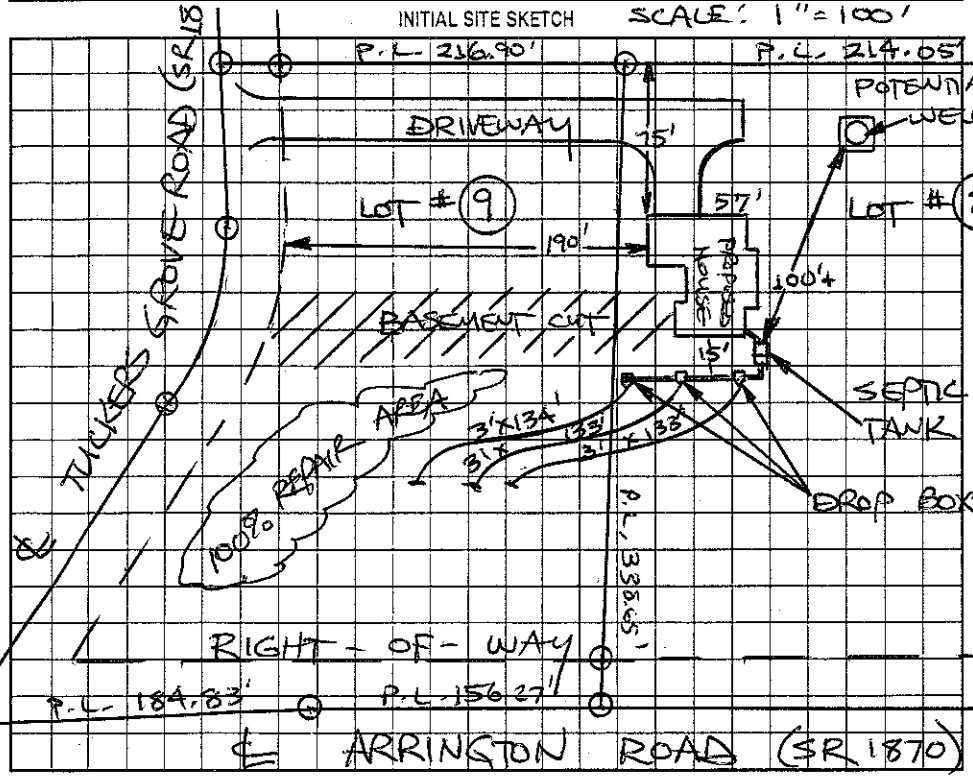

AS BUILT SKETCH

SYSTEM INSTALLED ACCORDING TO INITAL SITE SKETCH

Permit can be suspended or revoked if any false information is supplied toward securing the permit/any unauthorized changes are made to the site/any unauthorized changes are made in the installation of the system. Improvement Permit with plat valid without expiration. Improvement Permit with site plan valid for sixty months. Authorization to Construct is valid for a period equal to that of Improvement Permit – not to exceed sixty months.

Signed: [signature] date 11-6-02 Installed by: A-1 BACKHOE

Improvement Permit by: STEVE HEDRICK date 11-6-02 Operation Permit by: STEVE HEDRICK date 10-6-04

Authorization to Construct by: STEVE HEDRICK date 11-6-02 Existing System Inspection by: ____ date ____

HEALTH DEPT. COPY: WHITE OWNER COPY (FINAL): YELLOW OWNER COPY (INITIAL): PINK