DRAFT

IREDELL COUNTY HEALTH DEPARTMENT

STATESVILLE 704-878-5305 (ab) MOORESVILLE 704-664-5281

IMPROVEMENT PERMIT / AUTHORIZATION TO CONSTRUCT / OPERATION PERMIT / EXISTING SYSTEM INSPECTION

PERMIT # 158261 PIN # 4821 ~~50 88~~ 12022 DATE 10-13-09

OWNER or APPLICANT DONALD HARMON PHONE: Business Home: 704-873-2547

OWNER or APPLICANT ADDRESS 632 TULLERS Grove RD Statesville NC 28625

LOCATION / DIRECTIONS 115 N (R) Bruce Farm (R) TULLERS Grove (L) (R) Box #632

SUBDIVISION BLOCK / SECTION LOT # 1 LOT AREA 2.93 DESIGN FLOW L.T.A.R.

Septic Tank 1000 Gallons: STB 760 Date 9-12-09
Pump Tank Gallons: P T Date
Pump Make Model Serial #
Nitrification Field No Fields 1 No Lines 4 Linear Feet 300'
Trench Width 36" Max. Trench Bottom Depth 36" Gravel Depth N/A

☒ New System ☐ Repair ☐ Expansion System Type I II (III) IV V VI
System Description: 60% 25% REDUCTION
Repair System Description: SAME
Maintenance Agreement Required ☐ YES ☒ NO
☒ GRAVITY ☐ PRESSURE

☒ Residence No. Bedrooms 3
☐ Business No. Persons
☐ Other No. Employees
☐ Slab ☒ Crawl Space
☐ Basement w/plumbing ☐ Basement w/o plumbing

Water Supply: ☒ Private ☒ Public ☐ Community

Comments / Conditions (1) Owner Requests 25% REDUCTION System (2) Well must be 100' Away (2) Install lines on contours as flagged & maintain set backs. (3) System & HOUSE IS ELEVATED out Completely (4) DELL SITE IS NOT Permitted.

Comments / Conditions A well permit must be obtained to determine exact well area.

INITIAL SITE SKETCH

SEE ATTACHED SYSTEM DESIGN BY LOWE LOOK RES.

AS BUILT SKETCH

Red filler

Permit can be suspended or revoked if any false information is supplied toward securing the permit / any unauthorized changes are made to the site / any unauthorized changes are made in the installation of the system.

☐ *IMPROVEMENT PERMIT w / plat valid without expiration* ☒ *IMPROVEMENT PERMIT w / site plan valid for 60 mos.*

☒ *AUTHORIZATION TO CONSTRUCT valid for period equal to IMPROVEMENT PERMIT-not to exceed 60 mo.*

Owner / Applicant Signature: Date 10/15/09

Improvement Permit by: Date 10/12/09

Authorization to Construct by: Date 10/13/09

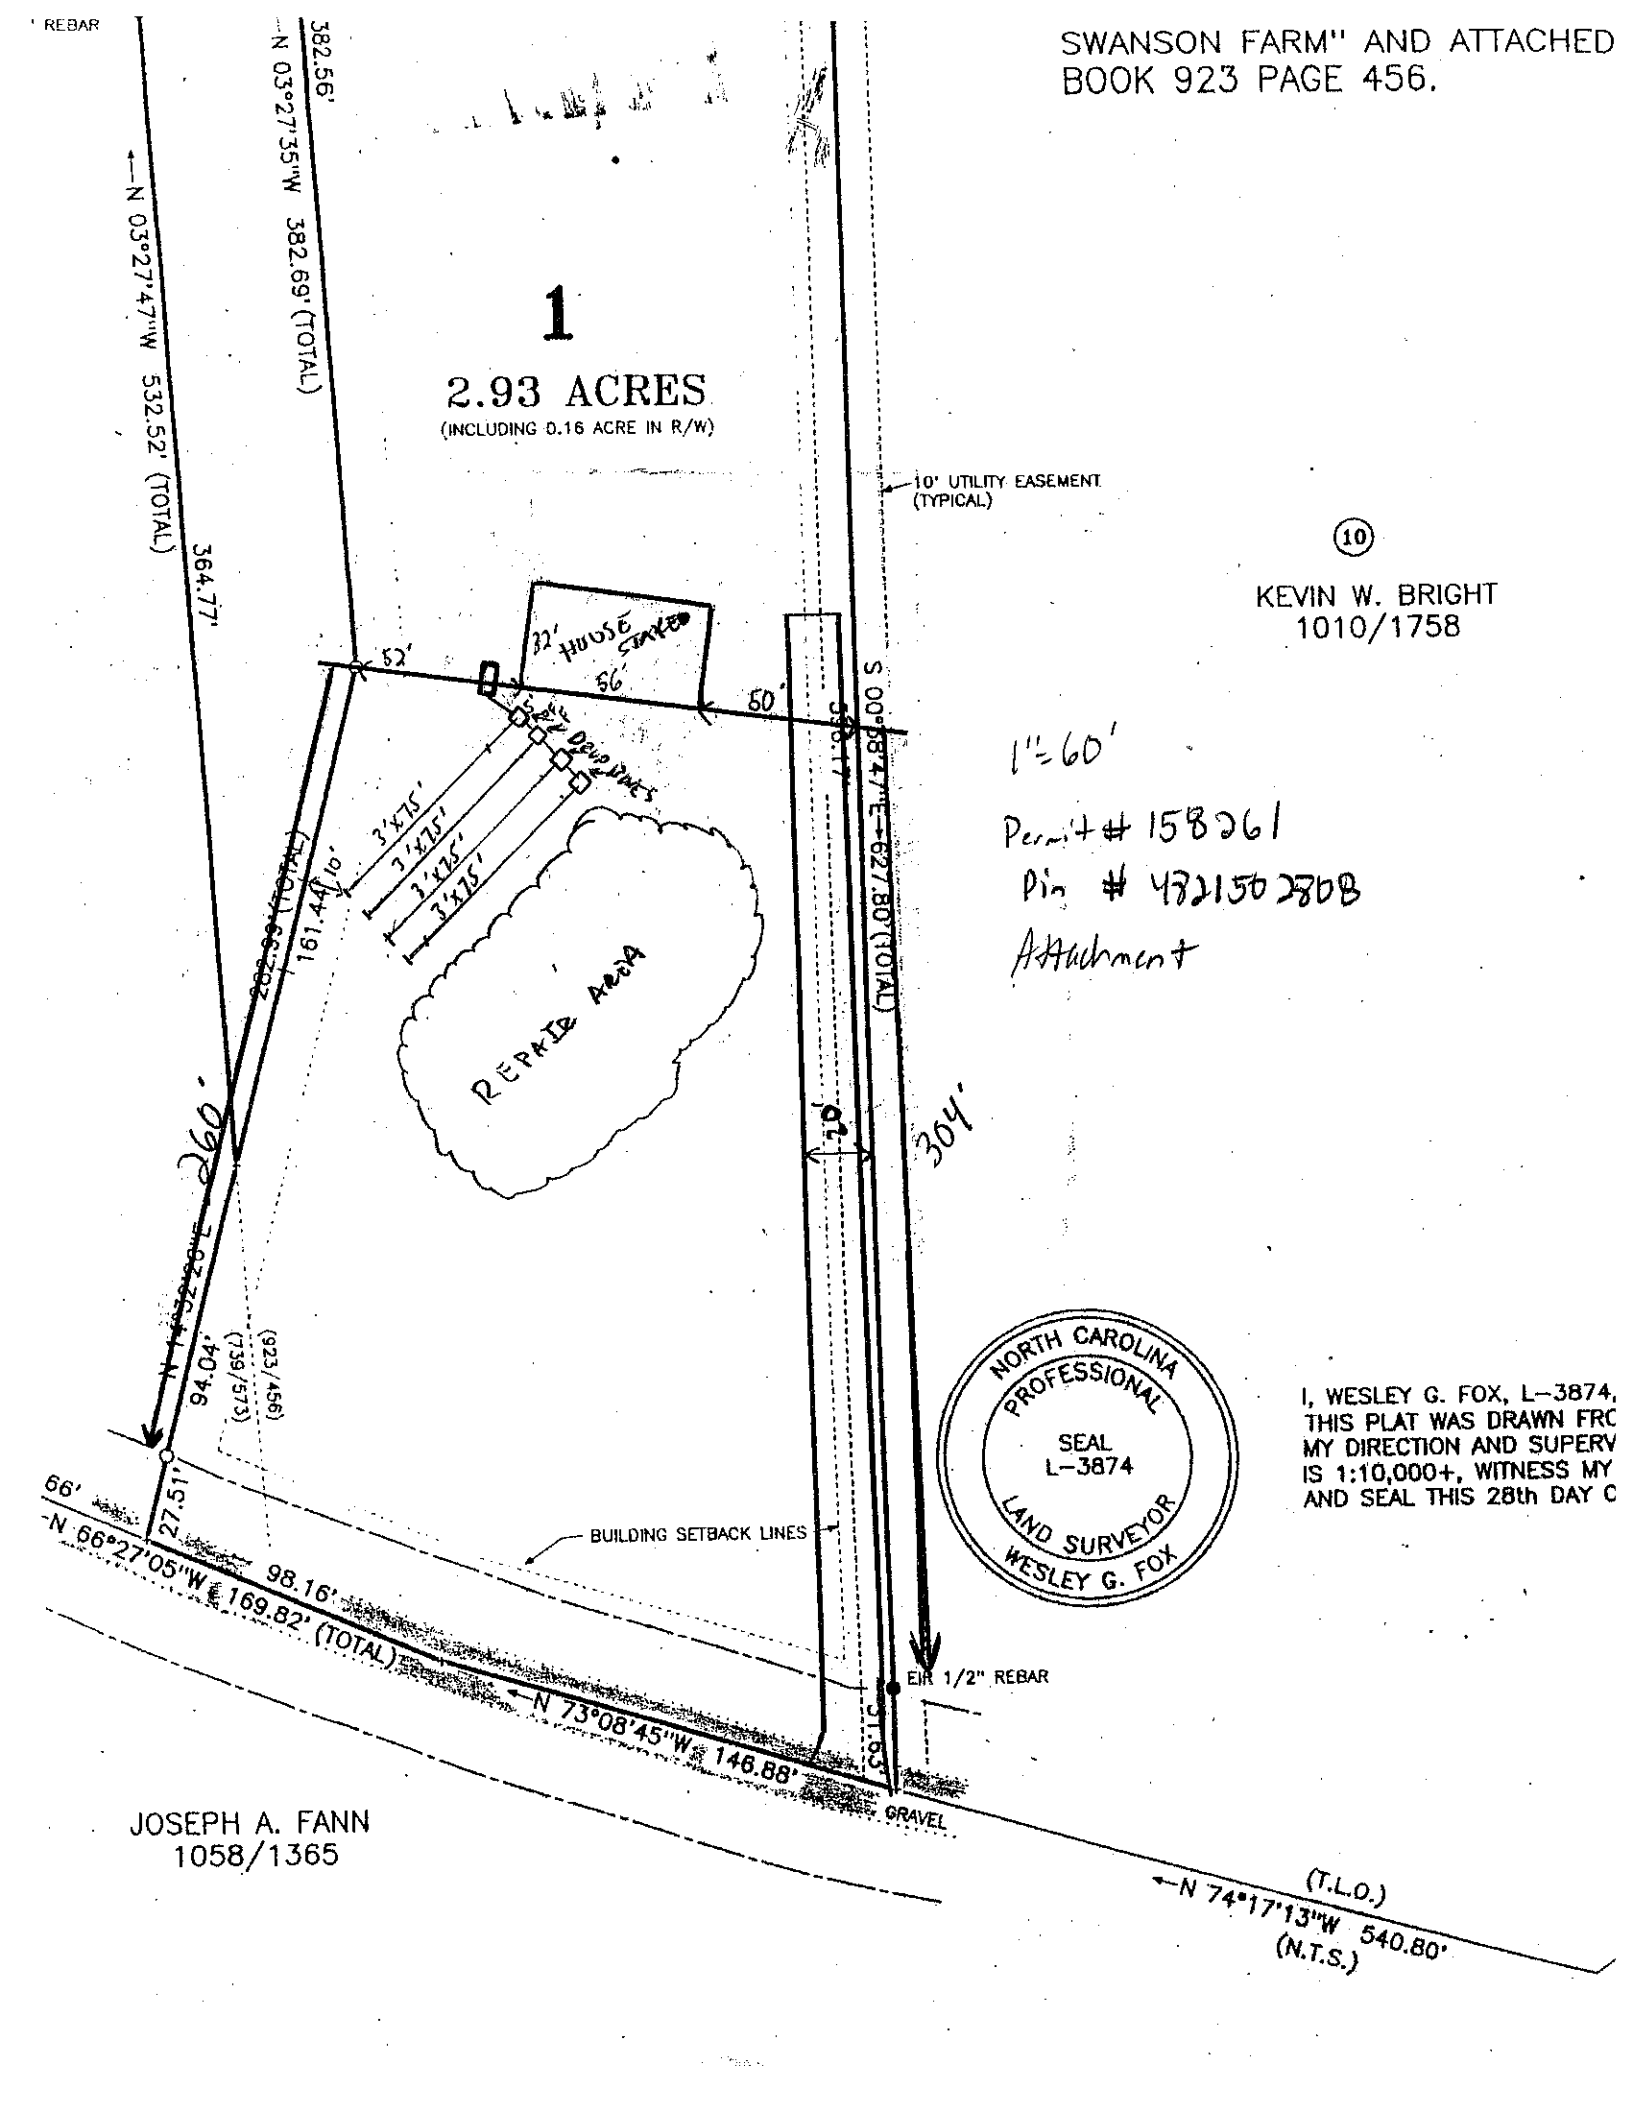
Installed by: Above Grading

Operation Permit by: Date: 12-8-09

Existing System Inspected by: Date:

YOU SHOULD CONTACT A LOCATOR SERVICE PRIOR TO ANY EXCAVATION.

WHITE COPY Environmental Health YELLOW COPY (Final) Owner / Applicant PINK COPY (Initial) Owner / Applicant


SWANSON FARM" AND ATTACHED
BOOK 923 PAGE 456.
1
2.93 ACRES
(INCLUDING 0.16 ACRE IN R/W)
10' UTILITY EASEMENT (TYPICAL)
(10)
KEVIN W. BRIGHT
1010/1758
1"=60'
Permit # 158061
Pin # 4821502808
Attachment
N 03°27'35"W 382.56'
N 03°27'47"W 532.52' (TOTAL)
382.69' (TOTAL)
364.77'
52'
32' HOUSE STAKED
56'
50'
S 00°08'47"E 627.80' (TOTAL)
580.17'
15' DOUBLE PINES
3'X75'
3'X75'
3'X75'
3'X75'
10'
191.44'
REPAIR AREA
304'
94.04'
(923/456)
(739/573)
66'
N 66°27'05"W 169.82' (TOTAL)
98.16'
N 73°08'45"W 146.88'
BUILDING SETBACK LINES
EIR 1/2" REBAR
51.63'
GRAVEL
JOSEPH A. FANN
1058/1365
(T.L.O.)
N 74°17'13"W 540.80'
(N.T.S.)
NORTH CAROLINA
PROFESSIONAL
SEAL
L-3874
LAND SURVEYOR
WESLEY G. FOX
I, WESLEY G. FOX, L-3874,
THIS PLAT WAS DRAWN FRO
MY DIRECTION AND SUPERV
IS 1:10,000+, WITNESS MY
AND SEAL THIS 28th DAY O