IREDELL COUNTY HEALTH DEPARTMENT

STATESVILLE 704-878-5305 MOORESVILLE 704-664-5281

IMPROVEMENT PERMIT / CERTIFICATE OF COMPLETION / OPERATION PERMIT / EXISTING SYSTEM INSPECTION

935

PROPERTY DESCRIPTION NO. 068396 DATE 7-25-97 TAX MAP NO. 4821 52 4154 Watershed: ☐ Yes ☑ No

OWNER OR CONTRACTOR DEWEY R. ROBERTS PHONE: Business _____ Home 876-6752

ADDRESS 189 BRUCE ROAD, STATESVILLE, NC 28677

LOCATION NC 115 N, TR BRUCE ROAD, MH BESIDE 3RD HOUSE ON LEFT

SUBDIVISION _____ BLOCK / SECTION _____ LOT _____ LOT AREA 0.649 ACRES SITE CLASS PS DESIGN FLOW 240 L.T.A.R. 0.33 GPD/FT²

Septic Tank: 1000 Gallons; STB 1007 Date 7-9-97

Pump Tank: _____ Gallons; PT _____ Date _____

Pump Make: _____ Model _____ Serial No. _____

Nitrification Field: No Fields 1 Square Feet 720 Linear Feet 240

No Lines FOUR Trench Width 36" Max Trench Bottom Depth 36" Gravel Depth 12"

☑ New System ☐ Repair System Type: I, II, III, IV, V, VI

System Description: CONVENTIONAL GRAVITY

Repair System Description: CONVENTIONAL PUMP

Maintenance Agreement Required: ☐ Yes ☑ No

☐ House/Mod. Home ☑ Mobile Home ☐ Business ☐ Other

No. Bedrooms 2 No. Bathrooms 2 No. Employees _____


☐ Slab ☑ Crawl Space ☐ Basement w/plumbing ☐ Basement w/o plumbing

Water Supply: ☑ Individual ☐ Community ☐ Public WELL


Comments:

Comments: NEXT DOOR

INITIAL SITE SKETCH SCALE: 1"=40'

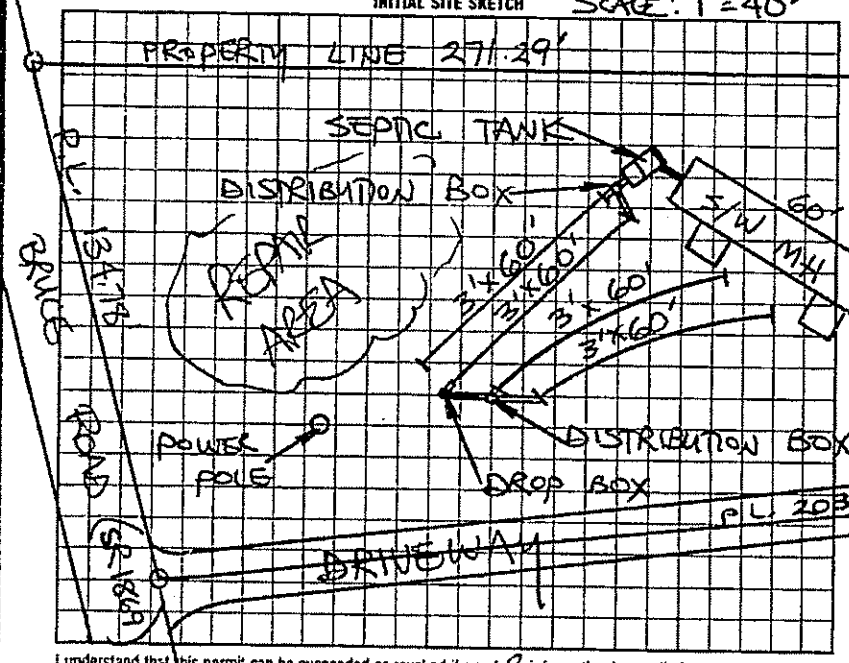

AS BUILT SKETCH

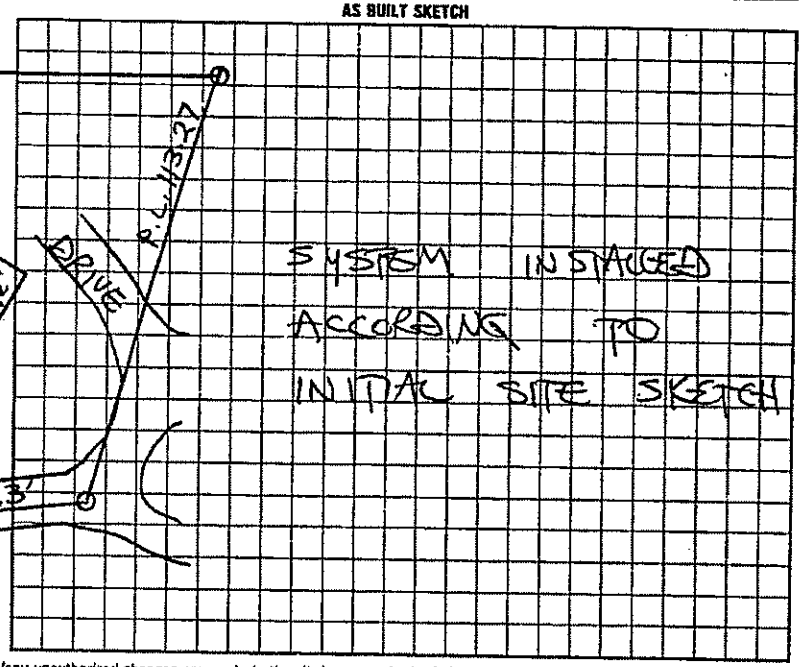

I understand that this permit can be suspended or revoked if any false information is supplied toward securing the permit/any unauthorized changes are made to the site/any unauthorized changes are made in the installation of the system. Improvement Permit is valid for 60 months from date of issuance. AUTHORIZATION TO CONSTRUCT IS VALID FOR 60 MONTHS FROM DATE OF ISSUANCE.

Signed: Dewey R Roberts

Improvement Permit by: STEVE HEDRICK date 7-26-97

AUTH. TO CONST.

Existing System Inspection by: STEVE HEDRICK date 7-25-97

Installed by: ANDY DANIELS

Certificate of Completion by: _____ date _____

Operation Permit by: STEVE HEDRICK date 8-8-97

HEALTH DEPT COPY WHITE INSPECTION COPY (FINAL) GREEN OWNER COPY (FINAL) YELLOW INSPECTION COPY (INITIAL) PINK OWNER COPY (INITIAL) GOLD

6 8 3 9 6