IREDELL COUNTY HEALTH DEPARTMENT

STATESVILLE 704-878-5305 MOORESVILLE 704-664-5281

IMPROVEMENT PERMIT / CERTIFICATE OF COMPLETION / OPERATION PERMIT / EXISTING SYSTEM INSPECTION

PROPERTY DESCRIPTION NO. 25878 DATE 1-10-97 TAX MAP NO. 4821524154 Watershed: ☐ Yes ☑ No

OWNER OR CONTRACTOR DEWEY ROBERTS PHONE: Business Home 876-6752

ADDRESS 189 BRUCE FARM ROAD, STATESVILLE, NC 28677

LOCATION NC 115 N, TR BRUCE FARM ROAD, TL AT BOX # 189 BACK OFF ROAD ~570'

SUBDIVISION BLOCK / SECTION LOT LOT AREA ~270'X125' SITE CLASS. PS1 DESIGN FLOW 360 L.T.A.R. 0.30 GPD/FT²

Septic Tank: 1000 Gallons; STB 1007 Date 5-20-97
Pump Tank: Gallons; PT Date
Pump Make: Model Serial No.
Nitrification Field: No Fields 1 Square Feet 1200 Linear Feet 400
No Lines FOUR Trench Width 36" Max Trench Bottom Depth 36" Gravel Depth 12"

☑ New System ☐ Repair System Type: I, II, III, IV, V, VI
System Description: CONVENTIONAL GRAVITY
Repair System Description: CHAMBERED GRAVITY
Maintenance Agreement Required: ☐ Yes ☑ No


☐ House/Mod. Home ☑ Mobile Home ☐ Business ☐ Other
No. Bedrooms 3 No. Bathrooms 2 No. Employees
☐ Slab ☑ Crawl Space ☐ Basement w/plumbing ☐ Basement wo/plumbing

Water Supply: ☑ Individual ☐ Community ☐ Public WELL

Comments: ① KEEP SYSTEM MINIMUM 100' FROM WELL
② INSTALL LINES ON CONTOUR USING SERIAL DISTRIBUTION

Comments:

INITIAL SITE SKETCH

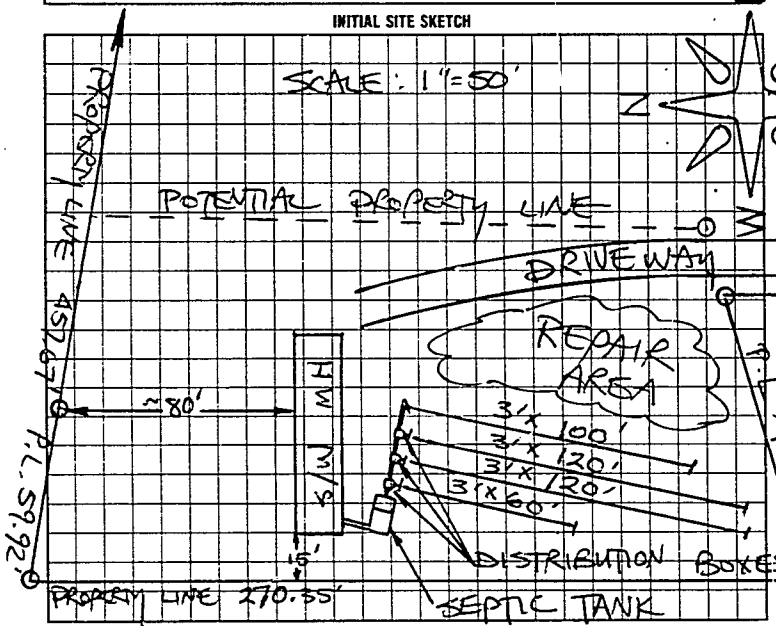

AS BUILT SKETCH

Installed as Shown

I understand that this permit can be suspended or revoked if any false information is supplied toward securing the permit/any unauthorized changes are made to the site/any unauthorized changes are made in the installation of the system. Improvement Permit is valid for 60 months from date of issuance. AUTH. TO CONST. IS VALID FOR 60 MONTHS FROM DATE OF ISSUANCE.

Signed: Dewey R Roberts

Installed by: Andy Daniels

Improvement Permit by: STEVE HEARICK date 1-10-97

AUTH TO CONST Existing System Inspection by: STEVE HEARICK date 1-10-97

Certificate of Completion by: date

Operation Permit by: Mary Coutts date 6-27-97

HEALTH DEPT. COPY WHITE INSPECTION COPY (FINAL) GREEN OWNER COPY (FINAL) YELLOW INSPECTION COPY (INITIAL) PINK OWNER COPY (INITIAL) GOLD

96200