IREDELL COUNTY HEALTH DEPARTMENT - *ENVIRONMENTAL HEALTH* ☐ STATESVILLE OFFICE 704-878-5305 ☐ MOORESVILLE OFFICE 704-664-5281

IMPROVEMENT PERMIT / AUTHORIZATION TO CONSTRUCT / OPERATION PERMIT / EXISTING SYSTEM INSPECTION

PERMIT # 168729 PIN # 4821-52-2245 DATE 19 October 11

OWNER Raymond Sapp APPLICANT: First Choice Homes PHONE: Home/Cell # (704) 902-7308 Business #

SITE ADDRESS 123 Roberts Farm Rd. OWNER / APPLICANT ADDRESS


SITE DIRECTIONS 115N TR Bruce Farm Rd. TL Roberts Farm Rd. - on Left.

SUBDIVISION BLOCK / SECTION LOT # LOT AREA DESIGN FLOW 360 g/d L.T.A.R. 0 Ex.

Septic Tank Ext.	Gallons: STB	Date	~~New~~ System ☐ Repair ☐ Expansion System Type I II III IV V VI		☑ Residence	No. Bedrooms 3	Water Supply	
Pump Tank	Gallons: P T	Date	System Description: convent. gravel trench		☐ Business	No. Persons	☐ Private	
Pump Make	Model	Serial #	Repair System Description:		☐ Other	No. Employees	☑ Public	
No. Nitrification Fields: Ex	No. Lines Ex	Linear Feet Ex	Maintenance Agreement Required ☐ YES ☑ NO		☐ Slab	☑ Crawl Space	☐ Community	
Trench Width Ex	Max. Trench Bottom Depth Ex	Gravel Depth Ex	☑ GRAVITY ☐ PRESSURE		☐ Basement w/plumbing	☐ Basement w/o plumbing		

Comments / Conditions

INITIAL SITE SKETCH

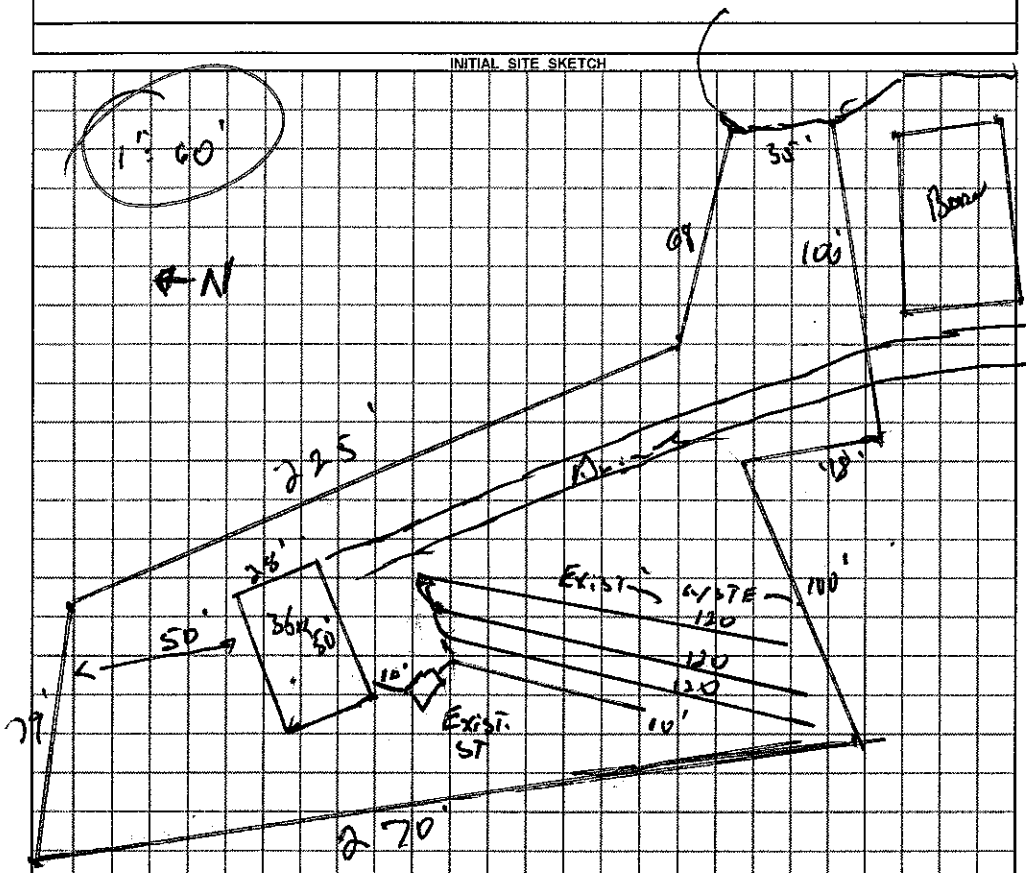

AS BUILT SKETCH

Permit can be suspended or revoked if any false information is supplied toward securing the permit / any unauthorized changes are made to the site / any unauthorized changes are made in the installation of the system.

☐ ***IMPROVEMENT PERMIT*** *with plat valid without expiration.* ☐ ***IMPROVEMENT PERMIT*** *with ~~plat valid without expiration.~~ site plan valid 60 mo.* ☐ ***AUTHORIZATION TO CONSTRUCT*** valid for period equal to IMPROVEMENT PERMIT--not to exceed 60 mo.

Owner / Applicant Signature: Date 10/21/11 Installed by:

IMPROVEMENT PERMIT by: REHS Date OPERATION PERMIT by: REHS Date

AUTHORIZATION TO CONSTRUCT by: REHS Date Existing System Inspected by: REHS Date 19 Oct. 11

YOU SHOULD CONTACT A LOCATOR SERVICE PRIOR TO ANY EXCAVATION

White Copy -- Environmental Health YELLOW COPY (Final) Owner / Applicant PINK COPY (Initial) Owner / Applicant