IREDELL COUNTY HEALTH DEPARTMENT

STATESVILLE 704-878-5305 MOORESVILLE 704-664-5281

IMPROVEMENT PERMIT / AUTHORIZATION TO CONSTRUCT / OPERATION PERMIT / EXISTING SYSTEM INSPECTION

PERMIT# 072346 PIN# 4821 51 3980 (PT) DATE 4-3-98

OWNER OR CONTRACTOR DEWY ROBERTS PHONE: Business Home 876-6752

ADDRESS 189 BRUCE FARM ROAD, STATESVILLE, NC 28677

LOCATION NC 115 N, TR BRUCE FARM ROAD, TL ROBERTS FARM LANE, AT END ON RIGHT

SUBDIVISION ROBERTS FARM BLOCK / SECTION LOT 4 LOT AREA 0.593 ACRE SITE CLASS. PS DESIGN FLOW 360 L.T.A.R. 0.33 GAD/FT2

Septic Tank: 1000 Gallons; STB 1012 Date 3-2-98

Pump Tank: Gallons; PT Date

Pump Make: Model Serial No.

Nitrification Field: No Fields 1 Square Feet 1080 Linear Feet 360

No Lines FOUR Trench Width 36" Max Trench Bottom Depth 36" Gravel Depth 12"

☑ New System ☐ Repair System Type: I (II) III, IV, V, VI

System Description: CONVENTIONAL GRAVITY

Repair System Description: CHAMBERED PUMP

Maintenance Agreement Required: ☐ Yes ☑ No

☐ House/Mod. Home ☑ Mobile Home ☐ Business ☐ Other

No. Bedrooms 3 No. Bathrooms 2 No. Employees


☐ Slab ☑ Crawl Space ☐ Basement w/plumbing ☐ Basement wo/plumbing

Water Supply: ☑ Individual ☐ Public ☐ Community WELL

Comments:/Conditions:

Comments:/Conditions:

INITIAL SITE SKETCH SCALE: 1" = 50'

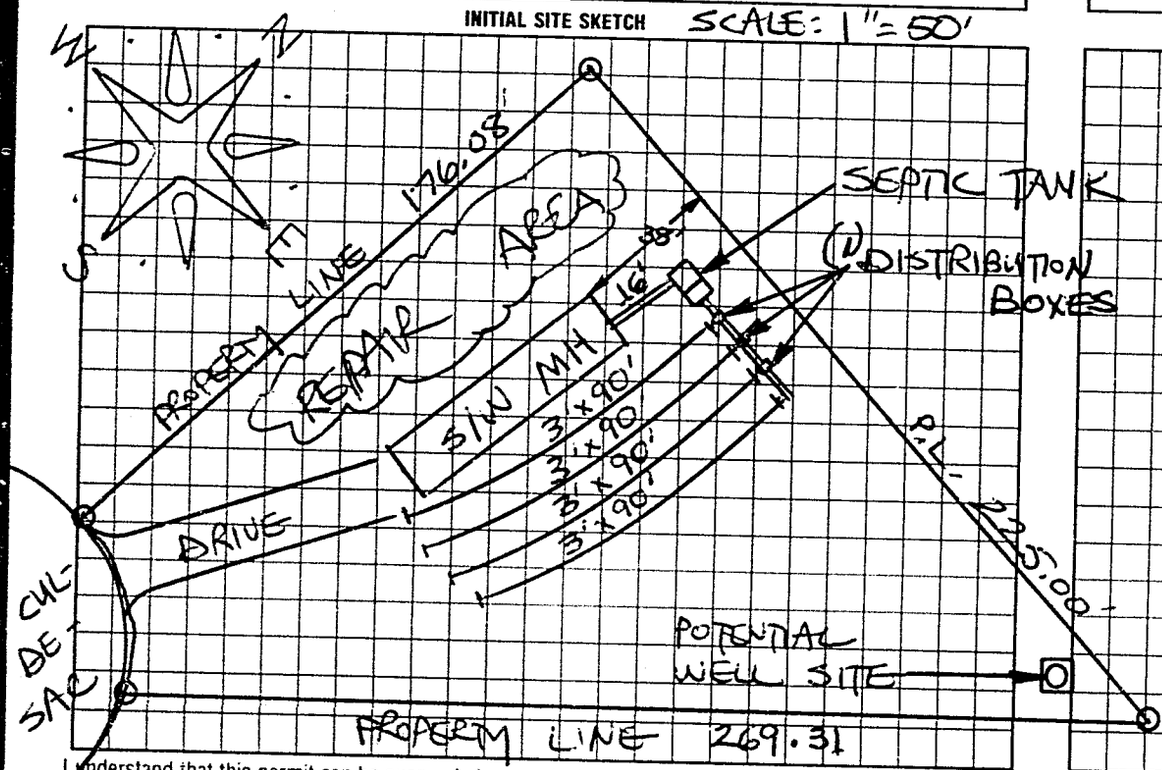

AS BUILT SKETCH

Installed as shown

I understand that this permit can be suspended or revoked if any false information is supplied toward securing the permit/any unauthorized changes are made to the site/any unauthorized changes are made in the installation of the system. Improvement Permit with plat valid without expiration. Improvement Permit with site plan valid for sixty months. Authorization to Construct is valid for a period equal to that of Improvement Permit – not to exceed sixty months.

Signed: Dewey R Roberts date 4,3,98

Improvement Permit by: STEVE HEDRICK date 4-3-98

Authorization to Construct by: STEVE HEDRICK date 4-3-98

Installed by: A-1 Backhoe

Operation Permit by: Mark C Outlaw date 5-4-98

Existing System Inspection by: date

HEALTH DEPT COPY: WHITE INSPECTION COPY (FINAL) GREEN OWNER COPY (FINAL) YELLOW INSPECTION COPY (INITIAL) PINK OWNER COPY (INITIAL) GOLD