IREDELL COUNTY HEALTH DEPARTMENT - *ENVIRONMENTAL HEALTH* ☒ STATESVILLE OFFICE 704-878-5305 ☐ MOORESVILLE OFFICE 704-664-5281

IMPROVEMENT PERMIT / AUTHORIZATION TO CONSTRUCT / OPERATION PERMIT / EXISTING SYSTEM INSPECTION

PERMIT # Repair PIN # 4821 52 5047 DATE July 27, 2011

OWNER Donald Bower APPLICANT: Linda Hoke / Property manager PHONE: Home/Cell # 828-612-0928 Business #

SITE ADDRESS 523 Ostwalt Amity Rd. OWNER / APPLICANT ADDRESS B Properties LLC 3914 Ridge Rd NE, Conover, NC 28613

SITE DIRECTIONS From I77-Exit 42 US21-115N TR Ostwalt Amity (SR1001) ~1½ miles on left, next to white concrete building (old store bld.)

SUBDIVISION BLOCK / SECTION LOT # 8 LOT AREA ¾-1Ac DESIGN FLOW 240 gpd L.T.A.R. # 3

Septic Tank ~~Existing~~ Gallons: STB 760 Date 7/10/11
Pump Tank Gallons: P T Date
Pump Make Model Serial #
No. Nitrification Fields: 1 No. Lines 2 Linear Feet 200
Trench Width 36" Max. Trench Bottom Depth 36" Gravel Depth NA


☐ New System ☒ Repair ☐ Expansion System Type I II (III) IV V VI
System Description:
Repair System Description: Gravity 25% Reduction
Maintenance Agreement Required ☐ YES ☒ NO
☒ GRAVITY ☐ PRESSURE

☒ Residence No. Bedrooms 2
☐ Business No. Persons
☐ Other No. Employees
☐ Slab ☒ Crawl Space
☐ Basement w/plumbing ☐ Basement w/o plumbing

Water Supply: ☒ Private ☐ Public ☐ Community

Comments / Conditions: X Check existing septic tank for condition after pumping. Replace w/ new 1000 gallon tank if needed. ~~Rerouted~~ Use existing machine to go into septic tank & maintain 5' or more off rear property line with repair drainfield. Use excavator to fill over area of current malfunction

INITIAL SITE SKETCH

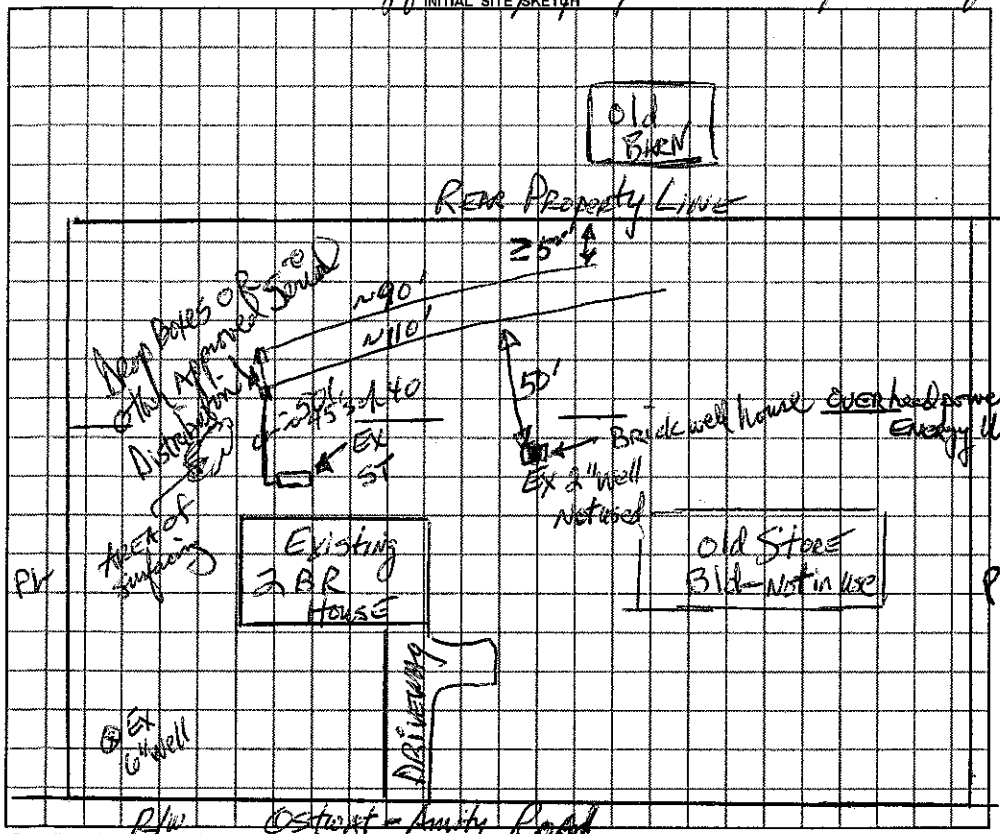

AS BUILT SKETCH

- New Septic tank installed
- Plumbing leak in house at time of inspection.
- Installed as Drawn using Infiltrator Q-16-4

Permit can be suspended or revoked if any false information is supplied toward securing the permit / any unauthorized changes are made to the site / any unauthorized changes are made in the installation of the system.

☐ ***IMPROVEMENT PERMIT*** with plat valid without expiration. ☒ ***IMPROVEMENT PERMIT*** with plat valid without expiration. site plan valid 60 mo. ☒ ***AUTHORIZATION TO CONSTRUCT*** valid for period equal to IMPROVEMENT PERMIT--not to exceed 60 mo.

Owner / Applicant Signature: Date 8-2-11 Installed by: A-1 Backhoe

IMPROVEMENT PERMIT by: REHS Date 7-27-11 OPERATION PERMIT by: REHS Date 9 Aug. 11

AUTHORIZATION TO CONSTRUCT by: REHS Date 7-27-11 Existing System Inspected by: REHS Date

YOU SHOULD CONTACT A LOCATOR SERVICE PRIOR TO ANY EXCAVATION

White Copy -- Environmental Health YELLOW COPY (Final) Owner / Applicant PINK COPY (Initial) Owner / Applicant