IREDELL COUNTY HEALTH DEPARTMENT - *ENVIRONMENTAL HEALTH* ☒ STATESVILLE OFFICE 704-878-5305 ☐ MOORESVILLE OFFICE 704-664-5281

IMPROVEMENT PERMIT / AUTHORIZATION TO CONSTRUCT / OPERATION PERMIT / EXISTING SYSTEM INSPECTION

PERMIT # Repair PIN # 4821 52 5047 DATE July 27, 2011

OWNER Donald Bower APPLICANT: Jenda Hoke / Property manager PHONE: Home/Cell # 828-612-0928 Business #

SITE ADDRESS 523 Ostwalt Amity Rd. OWNER / APPLICANT ADDRESS BProperties LLC 3914 Ridge Rd NE, Conover, NC 28613

SITE DIRECTIONS From I-77 - Exit 42 / US 21-115 N TR Ostwalt Amity (SR1001) ~1½ miles on left, next to white concrete building (old store bldg)

SUBDIVISION BLOCK / SECTION LOT # 8 LOT AREA 3/4 - 1 Ac DESIGN FLOW 240 gpd L.T.A.R. 3

Septic Tank ~~Existing~~ ~~Gallons~~: STB 760 Date 4/6/11 | ☐ New System ☒ Repair ☐ Expansion System Type I II (III) IV V VI | ☒ Residence No. Bedrooms 2 | Water Supply ☒ Private

Pump Tank Gallons: PT Date | System Description: | ☐ Business No. Persons | ☐ Public

Pump Make Model Serial # | Repair System Description: Gravity 25% Reduction | ☐ Other No. Employees | ☐ Community


No. Nitrification Fields: 1 No. Lines 2 Linear Feet 200 | Maintenance Agreement Required ☐ YES ☒ NO | ☐ Slab ☒ Crawl Space

Trench Width 36" Max. Trench Bottom Depth 36" Gravel Depth NA | ☒ GRAVITY ☐ PRESSURE | ☐ Basement w/plumbing ☐ Basement w/o plumbing


Comments / Conditions ~~X~~ Check existing septic tank for condition after pumping. Replace w/ new 1000 gallon tank if needed. Replace w/ Presbyterian Manufacturing Mactype 760 Series septic tank. Maintain 5' or more off rear property line with repair drainfield

Use excess dirt to fill over area of current malfunction

INITIAL SITE SKETCH

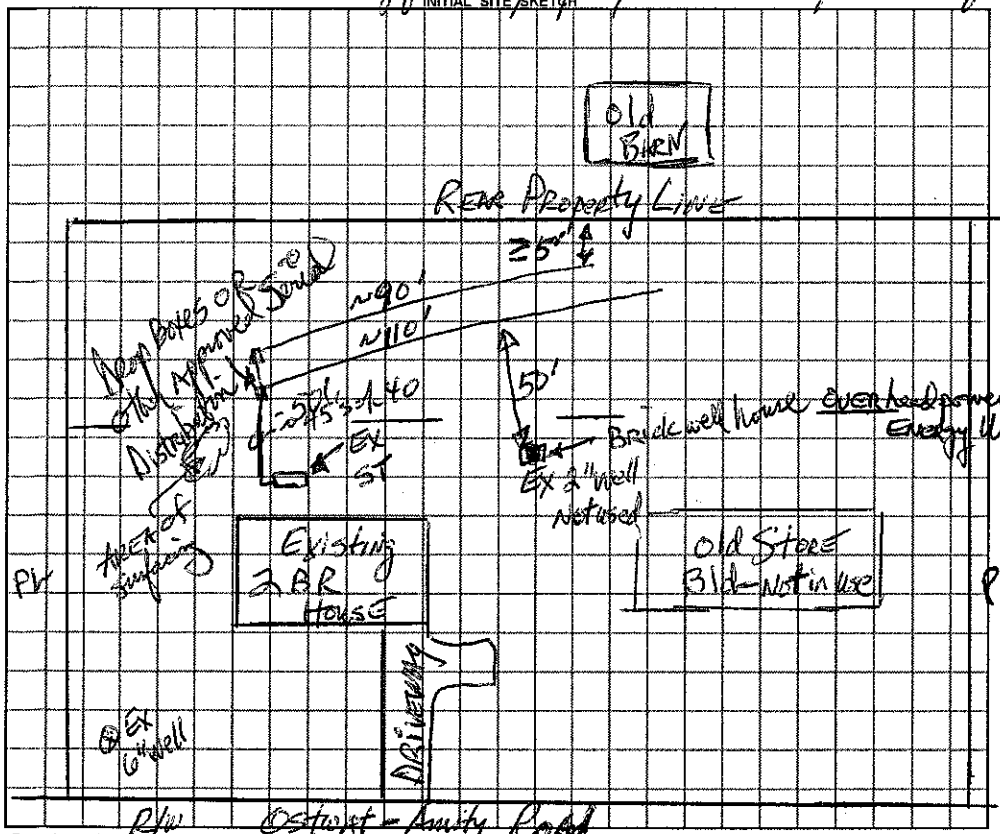

AS BUILT SKETCH

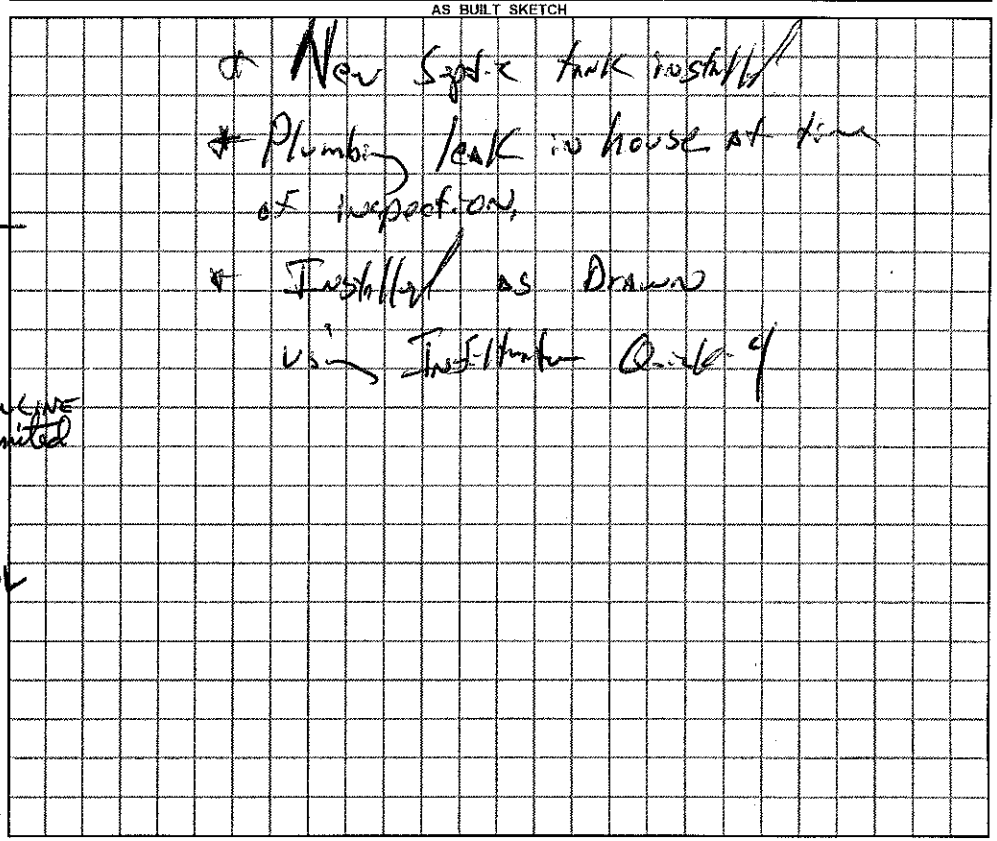

Permit can be suspended or revoked if any false information is supplied toward securing the permit / any unauthorized changes are made to the site / any unauthorized changes are made in the installation of the system.

☐ ***IMPROVEMENT PERMIT*** with plat valid without expiration. ☒ ***IMPROVEMENT PERMIT*** with plat valid without expiration. site plan valid 60 mo. ☒ ***AUTHORIZATION TO CONSTRUCT*** valid for period equal to IMPROVEMENT PERMIT--not to exceed 60 mo.

Owner / Applicant Signature: Date 8-2-11 Installed by: A-1 Backhoe

IMPROVEMENT PERMIT by: REHS Date 7-27-11 OPERATION PERMIT by: REHS Date 9 Aug. 11

AUTHORIZATION TO CONSTRUCT by: REHS Date 7-27-11 Existing System Inspected by: REHS Date

YOU SHOULD CONTACT A LOCATOR SERVICE PRIOR TO ANY EXCAVATION

White Copy – Environmental Health YELLOW COPY (Final) Owner / Applicant PINK COPY (Initial) Owner / Applicant