IREDELL COUNTY HEALTH DEPARTMENT

Statesville Office (704) 878-5305 Mooresville Office (704) 660-3625 PERMIT # 239124

SEPTIC IMPROVEMENT PERMIT / AUTHORIZATION TO CONSTRUCT / OPERATION PERMIT / EXISTING SYSTEM

PIN # 4821548996

APPLICANT/OWNER: Tina Gibson APPLICANT ADDRESS: 1639 Friendship Rd, Statesville

SITE ADDRESS: 1639 Friendship Rd, Statesville PHONE: 704-871-6949 ALT. PHONE —

SITE DIRECTIONS: 115 N → R on Friendship → 1st house on right SAP CONTROLLED: ☐ YES ☐ NO


SUBDIVISION: — SECTION: — LOT # — LOT AREA: 8.29ac DESIGN FLOW: ext L.T.A.R.: ext

Septic Tank	1500 (gal)	STB	964	Date	8/18/18	☐ New System ☒ Repair ☐ Expansion	System Type: I II III IV V VI	☒ Residence	No. Bedrooms Ext
Pump Tank	(gal)	PT		Date		System Description:		☐ Business	No. Persons Ext
Pump Make		Model		Serial #		Repair System Description:	tank replacement	☐ Other	No. Employees
# Nitrification Fields	ext	# Lines	ext	Linear Ft	ext	Maintenance Agreement Required:	☐ YES ☒ NO	☐ Slab	☐ Crawl Space
Trench Width	ext	Trench Bottom Depth(Low side)	ext	Gravel Depth	ext	☒ GRAVITY	☐ PRESSURE	☒ Basement w/plumbing	☐ Basement w/o plumbing


Water Supply: ☒ Private ☐ Public ☐ Community

Comments / Conditions: Pump, crush + fill existing cracked tank. Maintain minimum 5' setback from tank to slab. Replace D-box if needed.

INITIAL SITE SKETCH

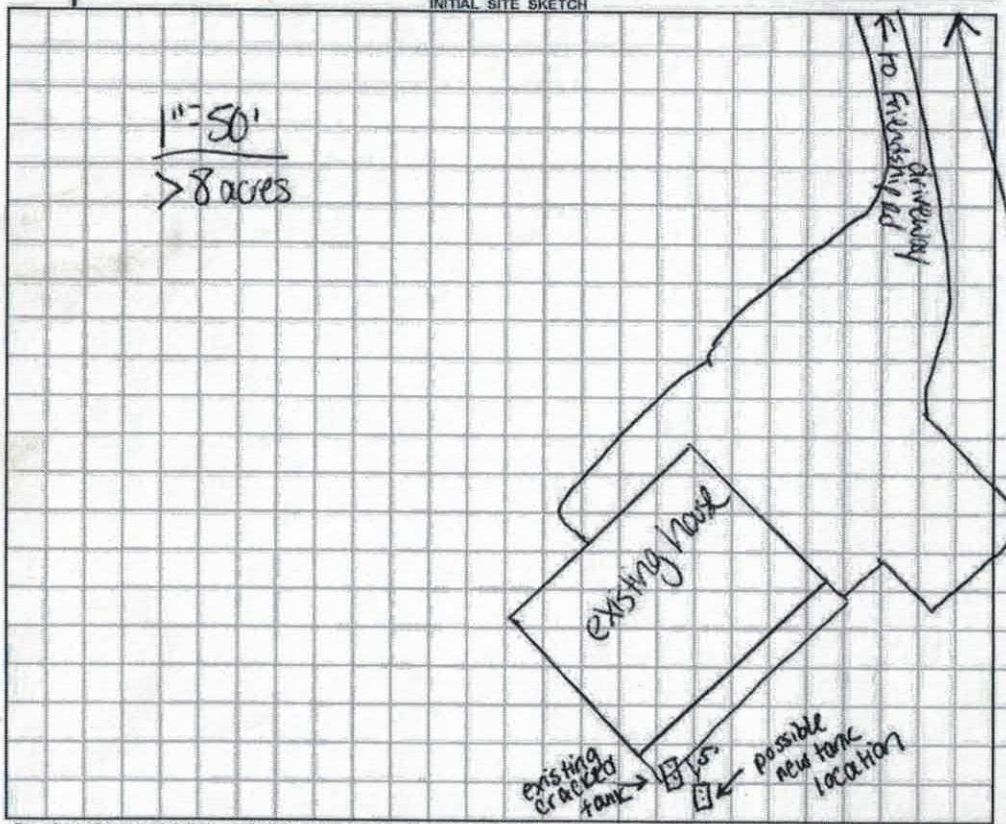

AS BUILT SKETCH

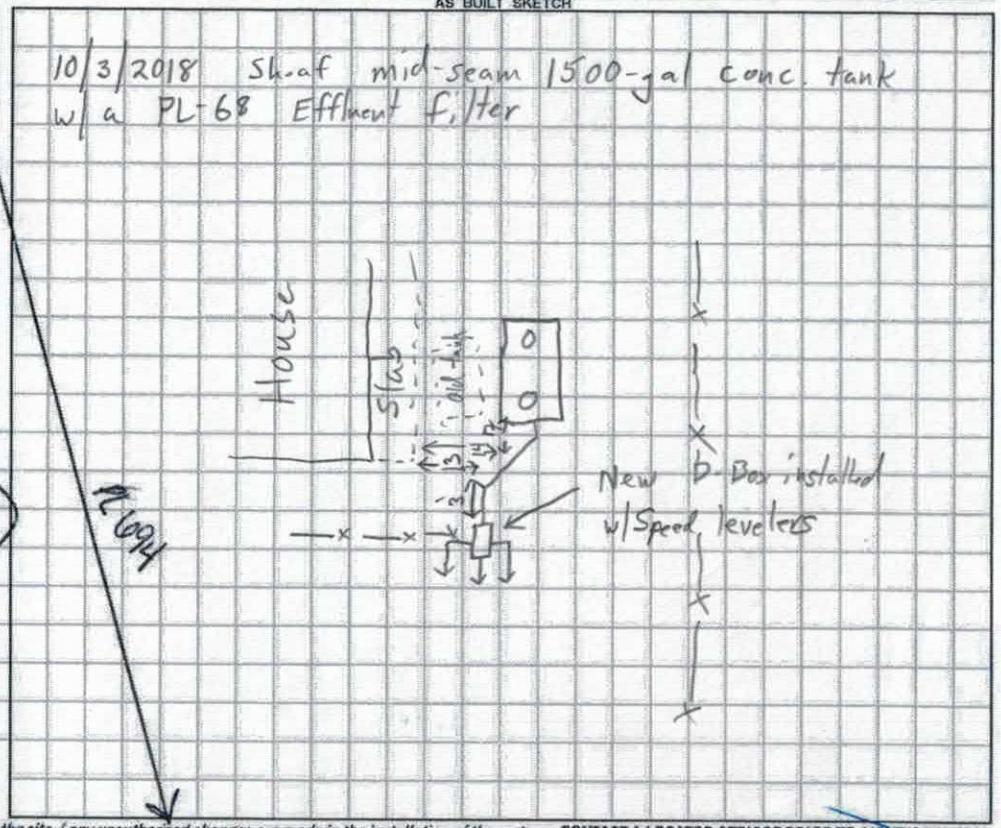

Permit can be suspended or revoked if any false information is supplied toward securing the permit / any unauthorized changes are made to the site / any unauthorized changes are made in the installation of the system. **CONTACT A LOCATOR SERVICE PRIOR TO ANY EXCAVATION**

☐ IMPROVEMENT PERMIT *with plat valid without expiration.* ☒ IMPROVEMENT PERMIT *with site plan valid for 60 mos.* ☒ AUTHORIZATION TO CONSTRUCT *valid for period equal to IMPROVEMENT PERMIT--not to exceed 60 mo.*

Owner / Applicant Signature: Tina Gibson Date: 9/28/18 Installed by: Jared Lentz

IMPROVEMENT PERMIT by: Carla C. Cave Date: 9/27/18 OPERATION PERMIT by: Tom Shuck Date: 10/3/2018

AUTHORIZATION TO CONSTRUCT by: Carla C. Cave Date: 9/27/18 Existing System Inspected by: Date:

FOR SEPTIC FINAL INSPECTION: CALL 704-664-3703 between 8am-9am the day the inspection is needed. Be sure to speak with an inpsector to confirm your inspection time.

731607 239124

RECEIVED SEP 2 6 2018

IREDELL COUNTY DEPARTMENT of ENVIRONMENTAL HEALTH

APPLICATION FORM

Application For: ( ) New Well Permit ( ) Well Repair Permit ( ) Well Abandonment
( ) Septic Improvement Permit ( ) Authorization to Construct ( ) Existing System Inspection (✓) Septic System Repair

THE ABOVE PERMIT DOCUMENTS WILL BECOME INVALID IF INFORMATION PROVIDED ON THIS APPLICATION IS FALSIFIED OR CHANGED, OR IF THE SITE IS ALTERED. THE IMPROVEMENT PERMIT IS VALID FOR EITHER 60 MONTHS OR WITHOUT EXPIRATION DEPENDING UPON DOCUMENTATION SUBMITTED. APPLICATION WITH SITE PLAN 60 MONTHS, APPLICATION WITH COMPLETE, SCALED PLAT WITHOUT EXPIRATION. SEE 15A NCAC 18A .1937(f) FOR DETAILS.

Page 2: *Site Plan Worksheet* form MUST accompany this application

The following optional attachments may also be submitted: ( ) Survey Plat, scaled no more than 1 inch = 60 feet
Place an (X) beside whichever is submitted if applicable ( ) Custom Site Plan, scaled no more than 1 inch = 60 feet

Applicant Information: (PRINT CLEARLY)

Applicant Name: Tina Gibson Address: 1639 Friendship Rd Zip: 28625
Applicant Email: tinagibsonnc@gmail.com Phone: 704-871-6949 Alt. Phone: 704-592-2437
Owner Name: Barney + Tina Gibson Address: 1639 Friendship Rd. Zip: 28625
Owner Email: Same Phone: _____ Alt. Phone: _____

Property Information:

Street Address: 1639 Friendship Rd., Statesville 28625
Subdivision Name: _____ Section/Phase: _____ Lot Number: _____
Driving Directions: Hwy 115 N, Right on Friendship, 1st house on Right

Site Development Information: *(check or complete ALL that apply*

( ) New Single Family Residence
( ) New Multi-Family Residence
( ) Accessory Building
( ) Bedroom(s) Addition
(✓) Repair to failing septic system
Maximum Number of Bedrooms: 5
Maximum Number of Occupants: 2
( ) Swimming Pool
( ) Other Addition/Structure: _____
✓ Tank ? Drain lines Describe Problem: Tank cracked, possible drainlines
Non-Residential Site Development: Type of Business: _____
Square Footage of Building: 3600 Max. Number of Employees: _____ Max. Number of Seats/Beds/Other: _____

CHECK FOUNDATION TYPE

( ) Crawl Space Foundation
( ) Concrete Slab Foundation
(✓) Basement with Plumbing
( ) Basement without Plumbing

Water Supply: ( ) Replacement Well – Reason: _____
( ) Multi-connection Well Number of Houses: 1 Number of Persons: 2
( ) New Well ( ) Existing Well ( ) Community Well ( ) City Water (✓) Other Public Water

Desired Septic System Type: *(you may rank in order of preference)* Year existing system installed: 1979
( ) No Preference ( ) Alternative ( ) Conventional ( ) Innovative ( ) Modified Conventional ( ) Other: _____

Please answer the following to the best of your ability:
( ) Yes ( ) No Does the site contain any jurisdictional wetlands?
( ) Yes ( ) No Is any non-domestic sewage (i.e. industrial) to be generated?
( ) Yes ( ) No Is the site subject to approval by any other public agency?

I have read this application and certify that the information provided herein is true, complete, and correct. Authorized county and state officials are granted right of entry to conduct necessary inspections to determine compliance with applicable laws and rules. I understand that I am solely responsible for the proper identification and labeling of all property lines and corners and making the site accessible so that a complete site evaluation can be performed.

Signature: Tina Gibson 9/26/18
Property owner or owner's legal representative signature (SIGNATURE REQUIRED) DATE

No Permit in DB

IREDELL COUNTY DEPARTMENT OF ENVIRONMENTAL HEALTH

DOCUMENTATION TO AUTHORIZE AN OWNER'S LEGAL REPRESENTATIVE

(Check and sign only ONE of the options below)

☑ 1. *** APPLICANT AND OWNER ARE THE SAME. *** (*Sign here*) Julia Gibson

Applications for permits require the "signature of the owner or owner's legal representative" (15A NCAC 18A .1937). If the owner does not sign the application himself or herself, they can submit any one of the following documents to designate their legal representative: *Power of Attorney; Real Estate Contract; Estate executor; Bankruptcy trustee; Court ordered guardianship*

In the absence of the above documentation, the property owner may provide the local health department with documentation that designates a legal representative. A property owner may:

Complete this form to document his or her legal representative, or provide his or her own form that contains the information in this form. If there are multiple property owners, then all property owners must sign the form that designates a legal representative.

By signing a form that designates a legal representative for purposes of 15A NCAC 18A .1937, the property owner authorizes that representative to act on their behalf in matters pertaining to the application and permitting process, including signing or receiving any application, document or permit. The owner retains full responsibility to meet all permit conditions specified by the local health department.

☑ 2. I, Julia Gibson, am the legal owner(s) of the property located at _____, identified as PIN (Parcel Identification Number)_____, located in Iredell County, North Carolina.

I do hereby authorize (**print legal representative/company name**)

Jarrid Lentz, lentz waste water, to act as an agent on my behalf in applying for/signing/obtaining any of the documents described below.

- Application for Improvement Permit (IP) / Authorization to Construct (AC)
- Improvement Permit (IP) / Authorization to Construct (AC)
- Application for soil-site evaluation (new/repair)
- Application/permit for private drinking water well/well abandonment
- Application for Compliance Inspection

I agree to abide by all decisions and/or conditions between the legal representative acting on my behalf and the Iredell County Department of Public Health, Environmental Health Division.

Julia Gibson
Signature of Owner(s)

9/26/18
Date

Mooresville - Environmental Health
ronda.hart@co.iredell.nc.us
Fax: 704-662-3239
610 E. Center Avenue, Mooresville, NC 28115

Statesville - Environmental Health
adrienne.shea@co.iredell.nc.us
Fax: 704-871-3483
349 N. Center Street, Statesville, NC 28677


IREDELL COUNTY DEPARTMENT of ENVIRONMENTAL HEALTH

SITE PLAN WORKSHEET

SEE THE "SAMPLE SITE PLAN" BELOW. *INCOMPLETE SITE PLANS WILL BE RETURNED TO YOU FOR COMPLETION AND MAY RESULT IN A DELAY IN THE ISSUANCE OF YOUR SEPTIC SYSTEM OR WELL PERMIT!!!*

Place an (X) beside each item as you complete the site plan:

- ( ) Property Line measurements are clearly identified
- ( ) All proposed structures are indicated
- ( ) Front and side setbacks from property line
- ( ) Preferred driveway location
- ( ) Preferred well location
- ( ) Preferred septic system location
- ( ) North arrow, or other sufficient indicator of direction

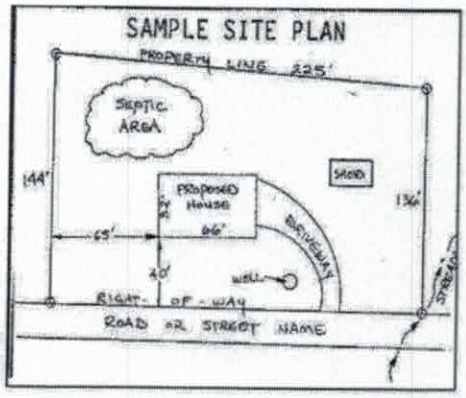


Circle N/A on the following if appropriate:

Location of septic systems and wells within 100' of your property	N/A
Location of easements and rights of ways on your property	N/A
Location of any designated wetlands on the property	N/A

USE THIS SPACE TO DRAW YOUR SITE PLAN

Show: proposed house or business footprint, wells, water lines, patios, pools and decks, and any other item that will occupy space on the site

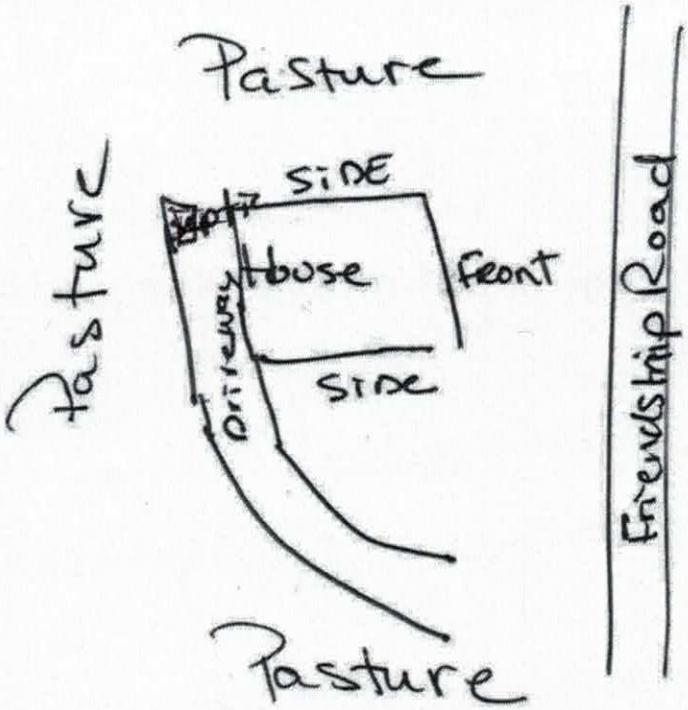

Signature: Julia Jackson

Property owner or owner's legal representative signature (SIGNATURE REQUIRED)

9/26/18

DATE