IREDELL COUNTY HEALTH DEPARTMENT - *ENVIRONMENTAL HEALTH* ☒ STATESVILLE OFFICE 704-878-5305 ☐ MOORESVILLE OFFICE 704-664-5281

IMPROVEMENT PERMIT / AUTHORIZATION TO CONSTRUCT (1) / OPERATION PERMIT (2) / EXISTING SYSTEM INSPECTION

PERMIT # 167598 PIN # 4821-55-1842 DATE 7-26-11

OWNER Douglas + Nanette Poston APPLICANT: PHONE: Home/Cell # 704-528-7960 Business #

SITE ADDRESS next to 1712 Friendship OWNER / APPLICANT ADDRESS

SITE DIRECTIONS Hwy 115N past Love Valley (R) on Friendship Road, lot on left next to 1712 Friendship

SUBDIVISION n/a BLOCK / SECTION n/a LOT # n/a LOT AREA 1.243 Acres DESIGN FLOW 360 L.T.A.R. .3

Septic Tank 1000 Gallons: STB 760 Date 3-13-11
Pump Tank Gallons: PT Date
Pump Make Model Serial #
No. Nitrification Fields: 1 No. Lines 3 Linear Feet 300 total
Trench Width 36" Max. Trench Bottom Depth 36" Gravel Depth n/a


☒ New System ☐ Repair ☐ Expansion System Type I II (III) IV V VI
System Description: 25% Reduction Gravity
Repair System Description: 25% Reduction Gravity
Maintenance Agreement Required ☐ YES ☒ NO
☒ GRAVITY ☐ PRESSURE

☒ Residence No. Bedrooms 3
☐ Business No. Persons
☐ Other No. Employees
☐ Slab ☒ Crawl Space
☐ Basement w/plumbing ☐ Basement w/o plumbing


Water Supply: ☐ Private ☒ Public ☐ Community

Comments / Conditions

INITIAL SITE SKETCH

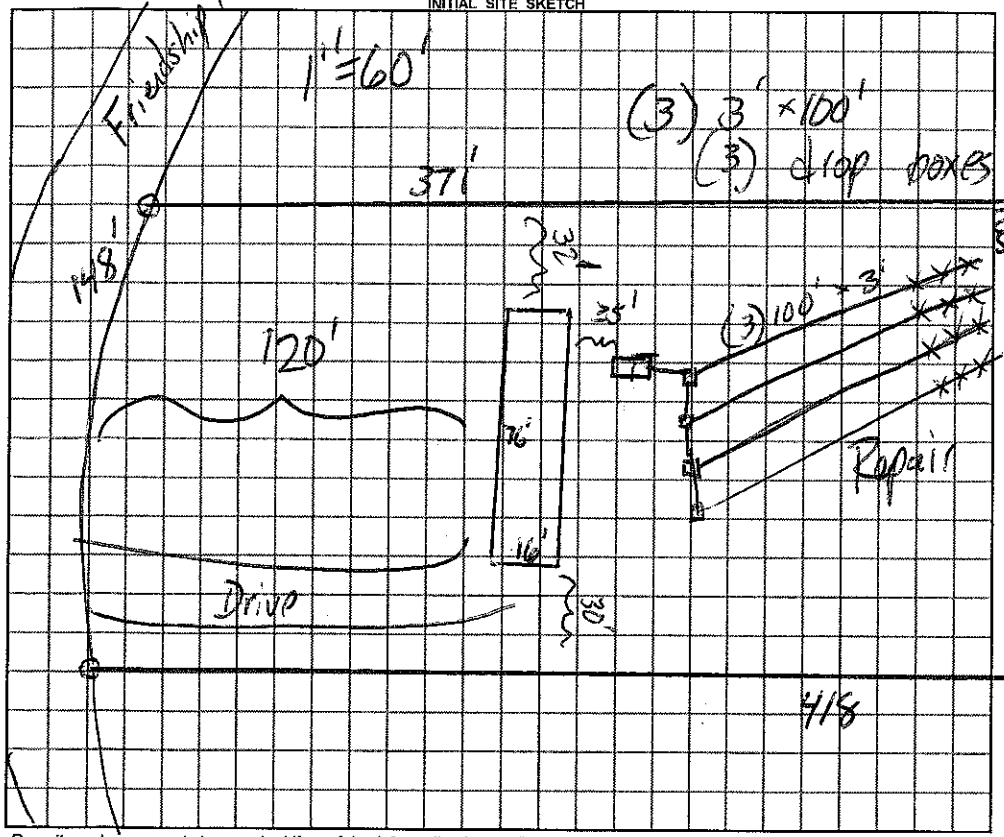

AS BUILT SKETCH

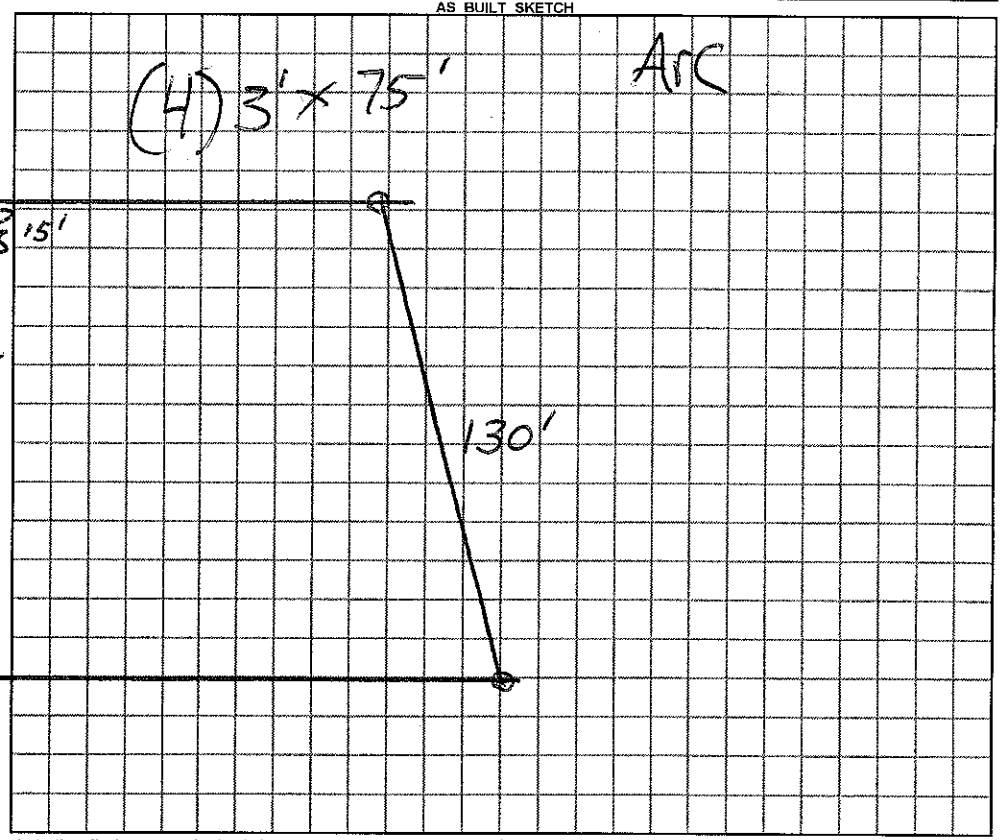

Permit can be suspended or revoked if any false information is supplied toward securing the permit / any unauthorized changes are made to the site / any unauthorized changes are made in the installation of the system.

☐ ***IMPROVEMENT PERMIT*** *with plat valid without expiration.* ☒ ***IMPROVEMENT PERMIT*** *with plat valid without expiration.* ☒ ***AUTHORIZATION TO CONSTRUCT*** valid for period equal to IMPROVEMENT PERMIT--not to exceed 60 mo.

Owner / Applicant Signature: *site plan valid 60 mo* Date 7-27-11

IMPROVEMENT PERMIT by: REHS Date 7-26-11

AUTHORIZATION TO CONSTRUCT by: REHS Date 7-26-11

YOU SHOULD CONTACT A LOCATOR SERVICE PRIOR TO ANY EXCAVATION

Installed by: Abee Grading

OPERATION PERMIT by: REHS Date 7-28-11

Existing System Inspected by: REHS Date

White Copy – Environmental Health YELLOW COPY (Final) Owner / Applicant PINK COPY (Initial) Owner / Applicant