IREDELL COUNTY HEALTH DEPARTMENT

STATESVILLE 704-878-5305 MOORESVILLE 704-664-5281

63742

IMPROVEMENT PERMIT / CERTIFICATE OF COMPLETION / OPERATION PERMIT / EXISTING SYSTEM INSPECTION

PROPERTY DESCRIPTION NO. 25227 DATE 10-14-96 TAX MAP NO. 15B - A - 29 Watershed: ☐ Yes ☑ No

OWNER OR CONTRACTOR ROGER WAY PHONE: Business Home 592-2181

ADDRESS 5086 WILKESBORO. Hwy STATESVILLE NC 28677

LOCATION NC 115 N TR PAST FRIENDSHIP Ch. RD AT BOX # 5086, BARN OFF ROAD

SUBDIVISION BLOCK / SECTION LOT LOT AREA ACREAGE SITE CLASS. PS DESIGN FLOW 360 L.T.A.R. 0.35 GPD/FT²

Septic Tank: 1000 Gallons; STB 1012 Date 8-18-96

Pump Tank: Gallons; PT Date

Pump Make: Model Serial No.

Nitrification Field: No Fields 1 Square Feet 1035 Linear Feet 345

No Lines THREE Trench Width 36" Max Trench Bottom Depth 36" Gravel Depth 12"

☑ New System ☐ Repair System Type: I, (II), III, IV, V, VI

System Description: CONV. GRAVITY

Repair System Description: CONV. PUMP

Maintenance Agreement Required: ☐ Yes ☑ No

☐ House/Mod. Home No. Bedrooms 3

☑ Mobile Home No. Bathrooms 2

☐ Business No. Employees

☐ Other


☐ Slab ☑ Crawl Space ☐ Basement w/plumbing ☐ Basement wo/plumbing

Water Supply: ☑ Individual ☐ Community ☐ Public WELL

Comments: ① CONSTRUCT SUBSURFACE INTERCEPT DRAINAGE DITCH AT LOCATION SHOWN BEGINNING 48" DEEP OUT TO DAYLIGHT ② KEEP SYSTEM MINIMUM 5' FROM MH, 10' FROM DRAINAGE DITCH, 50' FROM HIGH WATER MARK

Comments:

INITIAL SITE SKETCH

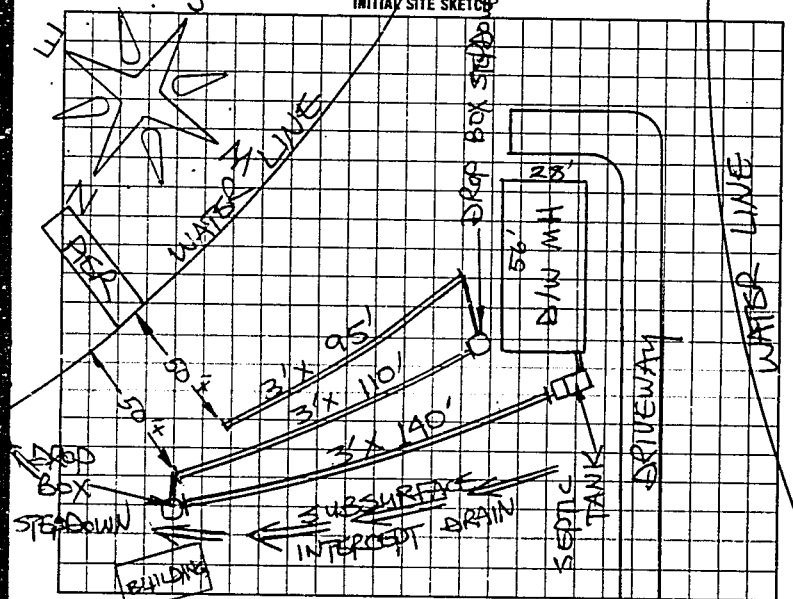

AS BUILT SKETCH

SYSTEM INSTALLED ACCORDING TO INITIAL SITE SKETCH

I understand that this permit can be suspended or revoked if any false information is supplied toward securing the permit/any unauthorized changes are made to the site/any unauthorized changes are made in the installation of the system.

Signed: Roger Way

IMPR. PERMIT TO CONST. IS VALID FOR A PERIOD EQUAL TO THE VALIDITY OF THE I.P. NOT TO EXCEED FIVE YEARS. I.P. W/ SITE PLAN IS VALID FOR FIVE YEARS.

Improvement Permit by: STEVE HENDRICK date 10-14-96

AUTHORIZATION TO CONSTRUCT

Existing System Inspection by STEVE HENDRICK date 10-14-96

Installed by: TIM AMMONS (MOORESVILLE)

~~Certificate of Completion~~ by: date

Operation Permit by STEVE HENDRICK date 10-30-96

HEALTH DEPT. COPY: WHITE | INSPECTION COPY (FINAL): GREEN | OWNER COPY (FINAL): YELLOW | INSPECTION COPY (INITIAL): PINK | OWNER COPY (INITIAL): GOLD