200

IREDELL COUNTY HEALTH DEPARTMENT

STATESVILLE 704-878-5305 MOORESVILLE 704-664-5281

IMPROVEMENT PERMIT / AUTHORIZATION TO CONSTRUCT / OPERATION PERMIT / EXISTING SYSTEM INSPECTION

PERMIT# 150812 PIN# 4821-59-8910

OWNER OR APPLICANT American Home Place DATE 26 June 08

ADDRESS 1266 Greenland Dr. Statesville PHONE: Business 704-873-4400 Home 704-507-0201

LOCATION 115N YR Sparkle Rd - TL Acute Rt. just past telephone exchange.

SUBDIVISION BLOCK / SECTION LOT 1 LOT AREA 3.197Ac. SITE CLASS. DS DESIGN FLOW 480 L.T.A.R. 0.3g/ft²d

Septic Tank: 1000 Gallons; STB 1000 Date 7-21-08

Pump Tank: Gallons; PT Date

Pump Make: Model Serial No.

Nitrification Field: No Fields 1 Square Feet 1600 Linear Feet 400

No Lines 5 Trench Width 36" Max Trench Bottom Depth 36

☑ New System ☐ Repair ☐ Expansion System Type: I II III IV V VI

System Description: 25% Reduction

Repair System Description: 25% Reduction

Maintenance Agreement Required: ☐ Yes ☑ No

Gravel Depth ☐ Gravity ☐ Pressure ☐ Slab ☑ Crawl Space ☐ Basement w/plumbing ☐ Basement wo/plumbing

☑ House/Mod. Home No. Bedrooms 4

☐ Mobile Home No. Persons

☐ Business No. Employees

☐ Other


Water Supply: ☑ Individual ☐ Public ☐ Community

Comments:/Conditions:


Follow contour / Horiz setbacks requirements.

Comments:/Conditions: Filter installed / ST has mark /

INITIAL SITE SKETCH (1"=60')

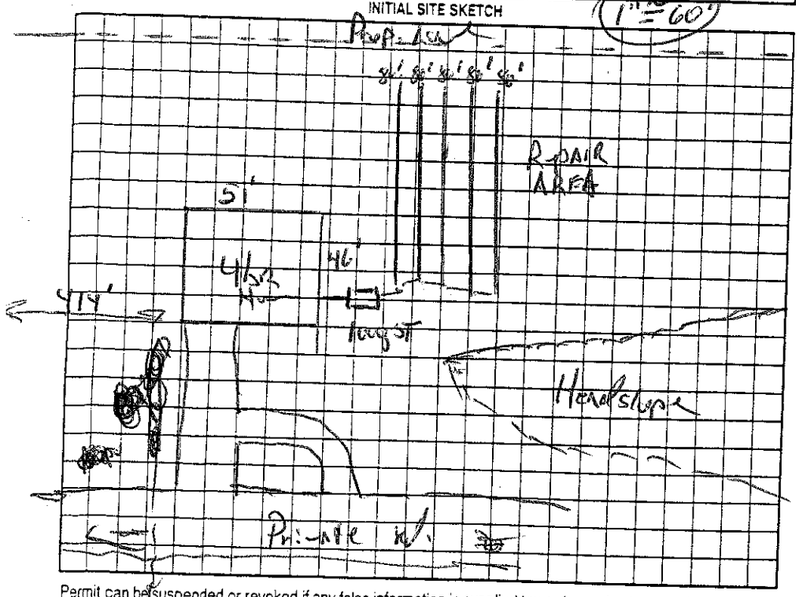

AS BUILT SKETCH

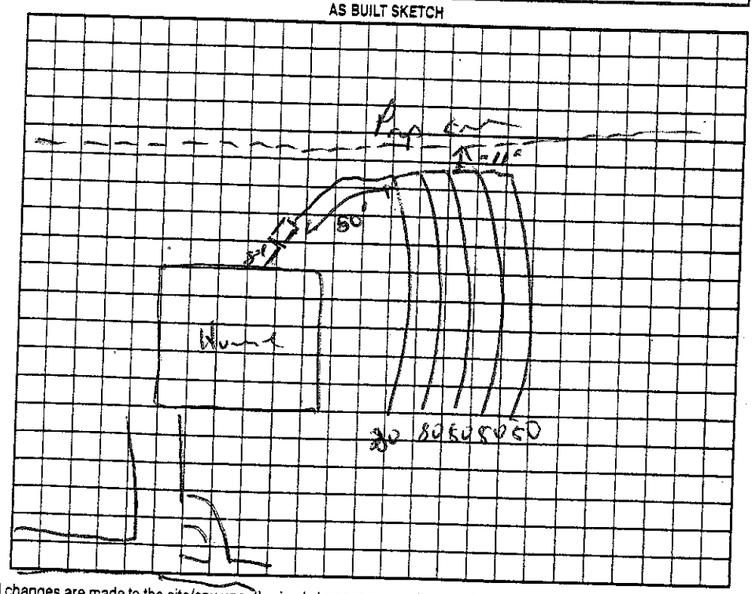

Permit can be suspended or revoked if any false information is supplied toward securing the permit/any unauthorized changes are made to the site/any unauthorized changes are made in the installation of the system. Improvement Permit with plat valid without expiration ☐ Improvement Permit with site plan valid for sixty months ☑ Authorization to Construct is valid for a period equal to that of Improvement Permit – not to exceed sixty months.

Signed: date 6-26-08

Improvement Permit by: R.S. date 26 June 08

Authorization to Construct by: R.S. date 26 June 08

Installed by: Kevin Boles

Operation Permit by: R.S. date 2 September 08

Existing System Inspection by: date

HEALTH DEPT. COPY: WHITE OWNER COPY (FINAL): YELLOW OWNER COPY (INITIAL): PINK