IREDELL COUNTY HEALTH DEPARTMENT

STATESVILLE 704-878-5305 MOORESVILLE 704-664-5281

IMPROVEMENT PERMIT / CERTIFICATE OF COMPLETION / OPERATION PERMIT / EXISTING SYSTEM INSPECTION

PROPERTY DESCRIPTION NO. 18136 DATE 3/30/94 TAX MAP NO. 14N-A-27A Watershed: ☐ Yes ☒ No

OWNER OR CONTRACTOR WILLIS BROWNING PHONE: Business Home 876-2237

ADDRESS RT-11 BOX 228, STVL, NC 28677

LOCATION NC 115N, TR BRUCE RD, ON (R) 1ST HOUSE PAST ARRINGTON ROAD

SUBDIVISION BLOCK / SECTION LOT LOT AREA 2.04 AC. SITE CLASS. DESIGN FLOW 360 L.T.A.R. EXISTING OK

Septic Tank: EXISTING Gallons; STB Date

Pump Tank: Gallons; PT Date

Pump Make: Model Serial No.

Nitrification Field: No Fields 2 Square Feet 300 Linear Feet 100

No Lines 1 Trench Width 36" Max Trench Bottom Depth 18-36" Gravel Depth 12"

☐ New System ☒ Repair System Type: I, ☒ II, III, IV, V, VI

System Description: CONV. GRAVITY

Repair System Description:

Maintenance Agreement Required: ☐ Yes ☒ No

☒ House/Mod. Home No. Bedrooms 3

☐ Mobile Home No. Bathrooms 2

☐ Business No. Employees 1

☐ Other BEDROOM ADDITION


☐ Slab ☒ Crawl Space ☐ Basement w/plumbing ☐ Basement wo/plumbing

Water Supply: ☒ Individual ☐ Community ☐ Public WELL

Comments: (1) CHECK OUT SEPTIC TANK FOR INTEGRITY, REPLACE SANITARY TEE IF NECESSARY (2) INSTALL NEW DIST. BOX AT LOCATION SHOWN (3) INSTALL NEW 3'x100' LINE, ON CONTOUR AS SHOWN.

Comments: TANK PUMPED OUT 4/13/94

INITIAL SITE SKETCH

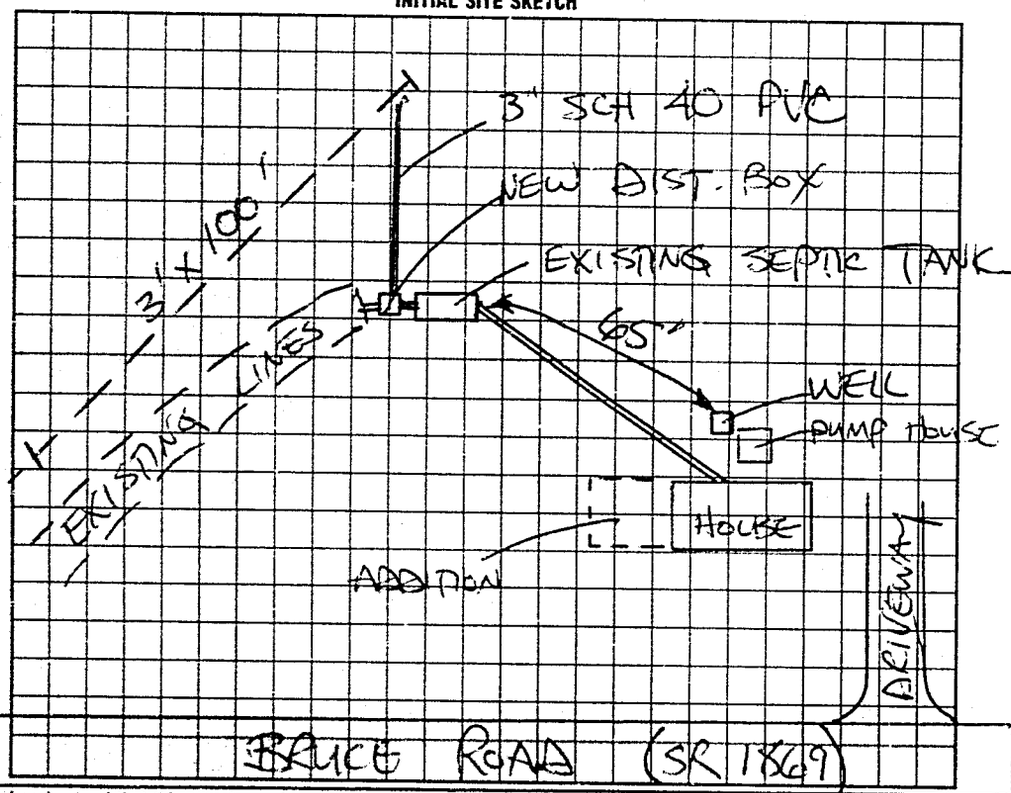

AS BUILT SKETCH

SYSTEM REPAIRED ACCORDING TO INITAL SITE SKETCH

I understand that this permit can be suspended or revoked if any false information is supplied toward securing the permit/any unauthorized changes are made to the site/any unauthorized changes are made in the installation of the system. Improvement Permit is valid for 60 months from date of issuance.

Signed: X William M. Browning

Improvement Permit by: STEVE HEARICK date 3/30/94

Existing System Inspection by: date

Installed by: WILLIS BROWNING

Certificate of Completion by: STEVE HEARICK date 4/14/94

Operation Permit by: date

HEALTH DEPT. COPY: WHITE INSPECTION COPY (FINAL): GREEN OWNER COPY (FINAL): YELLOW INSPECTION COPY (INITIAL): PINK OWNER COPY (INITIAL): GOLD