IREDELL COUNTY HEALTH DEPARTMENT

STATESVILLE 704-878-5305 MOORESVILLE 704-664-5281

IMPROVEMENT PERMIT / AUTHORIZATION TO CONSTRUCT / OPERATION PERMIT / EXISTING SYSTEM INSPECTION

PERMIT# 149685 PIN# 4821690636 DATE 5-28-08

OWNER OR APPLICANT John Schoonover PHONE: Business 704 592 5086 Home

ADDRESS Sprinkle Rd

LOCATION Hwy 115N, (R) on Sprinkle, Property on (R)

SUBDIVISION n/a BLOCK / SECTION LOT LOT AREA 69.35 SITE CLASS PS DESIGN FLOW 600 L.T.A.R. .3

Septic Tank: 1500 Gallons: STB 1014 Date 7-13-08

Pump Tank: Gallons: PT Date

Pump Make: Model Serial No.

Nitrification Field: No Fields 1 Square Feet 2000 Linear Feet 500

No Lines 5 Trench Width 36" Max Trench Bottom Depth 36" Gravel Depth

☑ New System ☐ Repair ☐ Expansion System Type: I II III IV V VI

System Description: 25% Reduction Gravity

Repair System Description: 25% Reduction Gravity

Maintenance Agreement Required: ☐ Yes ◉ No

☑ Gravity ☐ Pressure

☑ House/Mod. Home ☐ Mobile Home ☐ Business ☐ Other

No. Bedrooms 5 No. Persons No. Employees


Water Supply: ◉ Individual ☐ Public ☐ Community

☐ Slab ☐ Crawl Space ◉ Basement w/plumbing ☐ Basement wo/plumbing


Comments:/Conditions:

Comments:/Conditions:

INITIAL SITE SKETCH 1"=120'

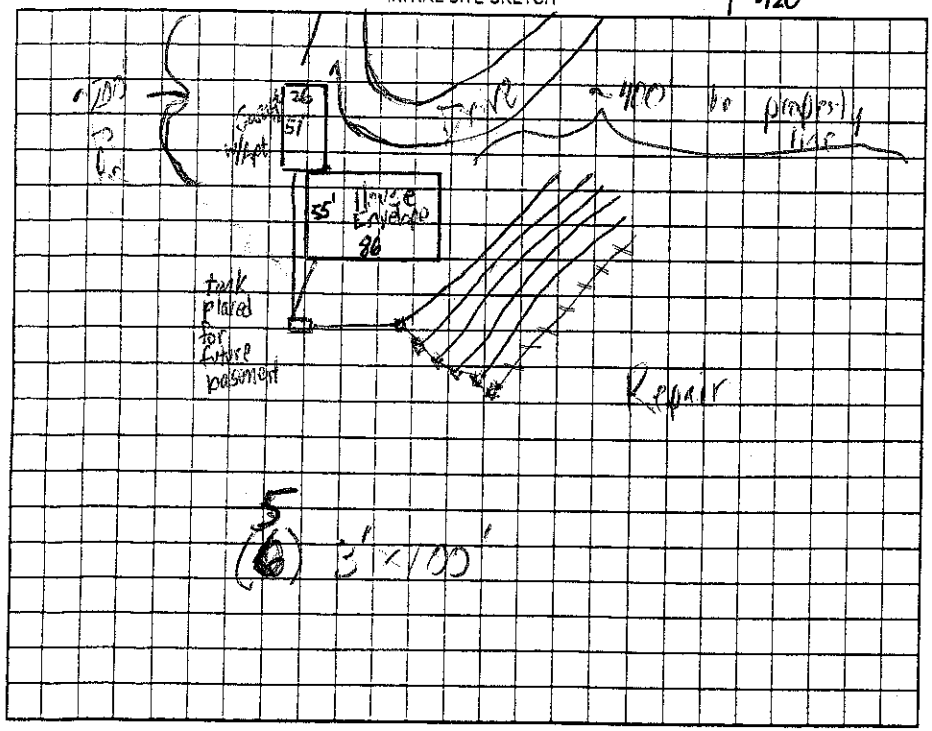

AS BUILT SKETCH

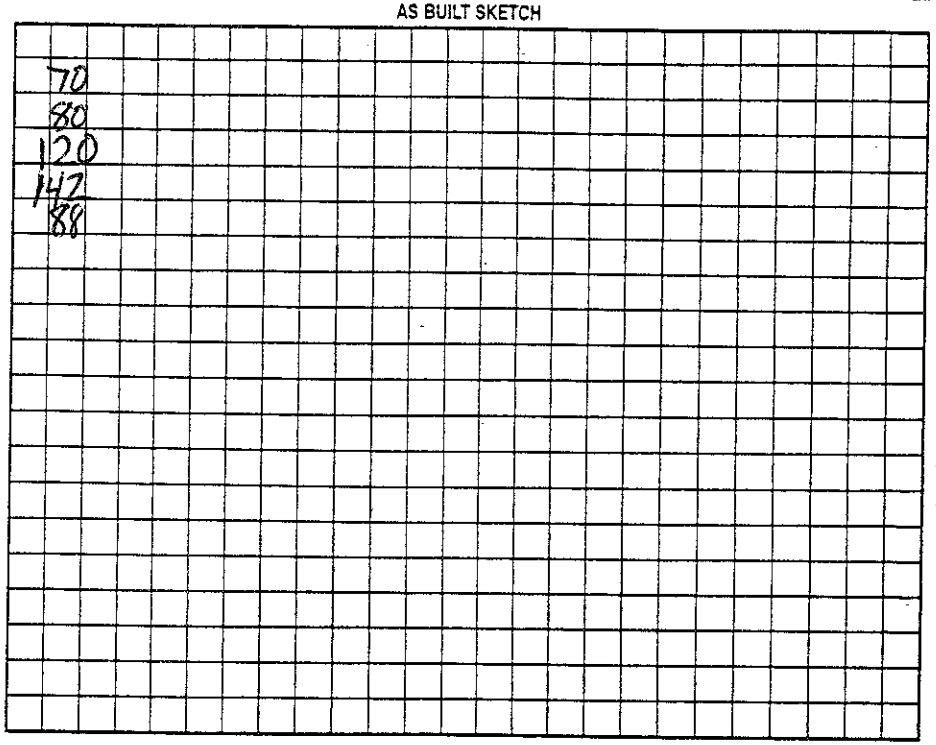

Permit can be suspended or revoked if any false information is supplied toward securing the permit/any unauthorized changes are made to the site/any unauthorized changes are made in the installation of the system. Improvement Permit with plat valid without expiration ☐ Improvement Permit with site plan valid for sixty months ☑ Authorization to Construct is valid for a period equal to that of Improvement Permit – not to exceed sixty months.

Signed: date 6-12-08 Installed by: Andy Daniels

Improvement Permit by: date 5-28-08 Operation Permit by: date 12-3-08

Authorization to Construct by: date 5-28-08 Existing System Inspection by: date

HEALTH DEPT. COPY: WHITE OWNER COPY (FINAL): YELLOW OWNER COPY (INITIAL): PINK