IREDELL COUNTY HEALTH DEPARTMENT

Statesville Office (704) 878-5305 Mooresville Office (704) 660-3625 PERMIT # 177038

IMPROVEMENT PERMIT / AUTHORIZATION TO CONSTRUCT / OPERATION PERMIT / EXISTING SYSTEM

PIN # 4821707938

APPLICANT: Todd Tilley APPLICANT ADDRESS: PO Box 5862 Statesville

SITE ADDRESS: 125 Tilley Farm Ln. PHONE: 704-437-8210 ALT. PHONE: N/A

SITE DIRECTIONS: 115N TR Bruce Farm Rd. TR Tilley Farm Ln. 1st drive on left

SUBDIVISION: N/A SECTION: N/A LOT # N/A LOT AREA: 6.34 acres DESIGN FLOW: 360gpd L.T.A.R.: existing

Septic Tank Existing (gal) STB Date

Pump Tank (gal) PT Date

Pump Make Model Serial #

Nitrification Fields 1 # Lines Existing Linear Ft: Ex

Trench Width Ex Max. Trench Bottom Depth Ex Gravel Depth 12"

☐ New System ☐ Repair ☐ Expansion System Type: I ☑ II III IV V VI

System Description: Conventional - gravity

Repair System Description:

Maintenance Agreement Required: ☐ YES ☑ NO

☑ GRAVITY ☐ PRESSURE

☑ Residence No. Bedrooms 2

☐ Business No. Persons

☐ Other No. Employees

☐ Slab ☑ Crawl Space

☐ Basement w/plumbing ☐ Basement w/o plumbing

Water Supply

☑ Private

☐ Public

☐ Community


Comments / Conditions:

- Maintain a minimum of 25' between home foundation & existing well. Maintain a minimum of 10' between home foundation and all components of septic tank system

INITIAL SITE SKETCH

Scale 1"=100'

AS BUILT SKETCH

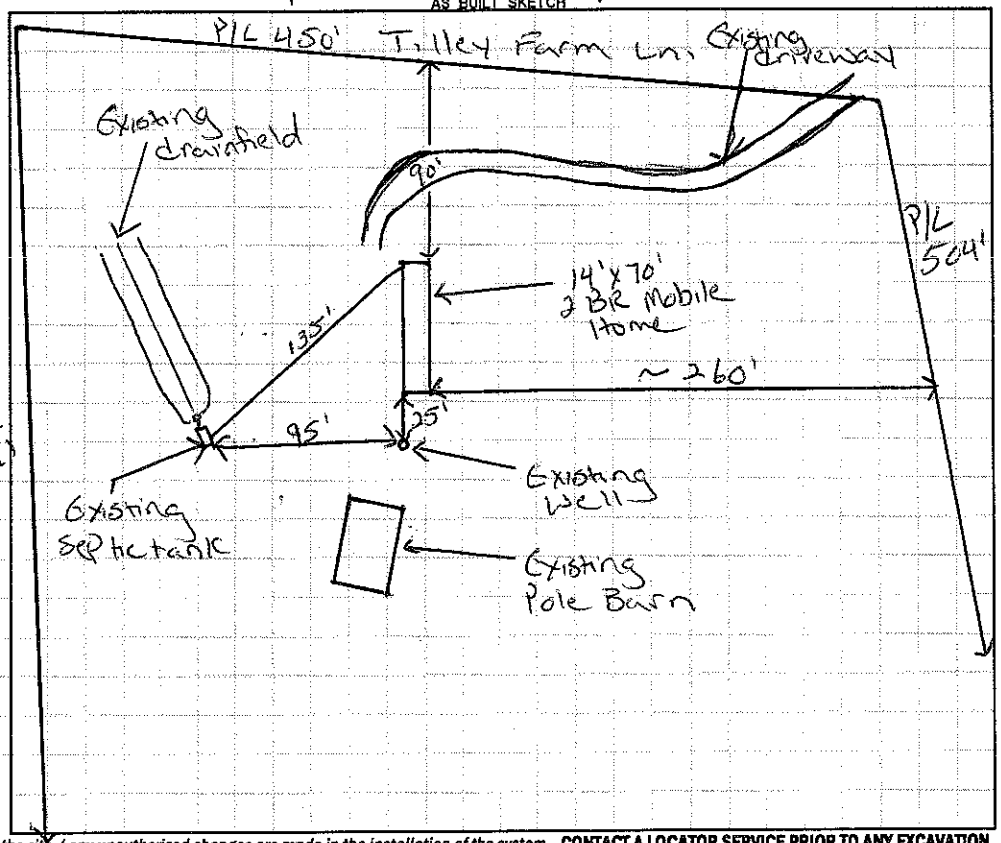

Permit can be suspended or revoked if any false information is supplied toward securing the permit / any unauthorized changes are made to the site / any unauthorized changes are made in the installation of the system. **CONTACT A LOCATOR SERVICE PRIOR TO ANY EXCAVATION**

☐ **IMPROVEMENT PERMIT** ***with plat*** *valid without expiration.* ☐ **IMPROVEMENT PERMIT** ***with site plan*** *valid for 60 mos.* ☐ **AUTHORIZATION TO CONSTRUCT** *valid for period equal to IMPROVEMENT PERMIT--not to exceed 60 mo.*

Owner / Applicant Signature: Date: Installed by:

IMPROVEMENT PERMIT by: Date: OPERATION PERMIT by: Date:

AUTHORIZATION TO CONSTRUCT by: Date: Existing System Inspected by: Justin Henderson Date: 2-11-13

Health Dept. Copy - WHITE Applicant (Final Approval) - YELLOW Applicant (Conditional Approval) - PINK