IREDELL COUNTY HEALTH DEPARTMENT

STATESVILLE 704-878-5305 MOORESVILLE 704-664-5281

IMPROVEMENT PERMIT / CERTIFICATE OF COMPLETION / OPERATION PERMIT / EXISTING SYSTEM INSPECTION

PROPERTY DESCRIPTION NO. 070449 DATE 11-14-97 TAX MAP NO. 482181 5747 (PT) Watershed: ☐ Yes ☑ No

OWNER OR CONTRACTOR RACHEL L. ARRINGTON PHONE: Business Home 592-7464

ADDRESS 831 MYERS MILL ROAD, OLIN, NC 28660

LOCATION NC 115 N, TR BRUCE ROAD, TL REX LANE, BEAR RIGHT TWICE, MH AT END.

SUBDIVISION BLOCK / SECTION LOT LOT AREA 25.69 ACRES SITE CLASS. PS DESIGN FLOW 240 L.T.A.R. 0.30 GPD/FT²

Septic Tank: 1000 Gallons; STB 1012 Date 9/8/97

Pump Tank: Gallons; PT Date

Pump Make: Model: Serial No.

Nitrification Field: No. Fields 1 Square Feet 810 Linear Feet 270

No Lines FOUR Trench Width 36" Max Trench Bottom Depth 36" Gravel Depth 12"

☑ New System ☐ Repair System Type: I, II, III, IV, V, VI

System Description: CONVENTIONAL GRAVITY

Repair System Description: CONV. PUMP

Maintenance Agreement Required: ☐ Yes ☑ No

☐ House/Mod. Home No. Bedrooms 3

☑ Mobile Home No. Bathrooms 2

☐ Business No. Employees

☐ Other


☐ Slab ☐ Crawl Space ☐ Basement w/plumbing ☐ Basement w/o plumbing

Water Supply: ☐ Individual ☐ Community ☑ Public

Comments: DIVERT DRAINAGE DITCH AS SHOWN

Comments:

INITIAL SITE SKETCH SCALE: 1"=30'

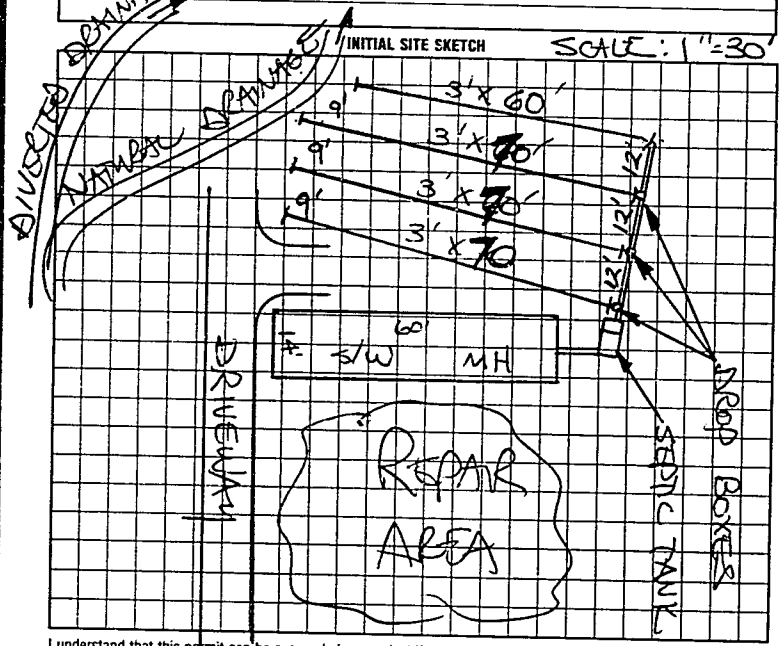

AS BUILT SKETCH

SYSTEM INSTALLED ACCORDING TO INITIAL SITE SKETCH

I understand that this permit can be suspended or revoked if any false information is supplied toward securing the permit/any unauthorized changes are made to the site/any unauthorized changes are made in the installation of the system. Improvement Permit is valid for 60 months from date of issuance. AUTHORIZATION TO CONSTRUCT IS VALID FOR 60 MONTHS FROM DATE OF ISSUANCE.

Signed: X Tom Arrington

Improvement Permit by: STEVE HEDRICK date 11-14-97

AUTH. TO CONST. Building System Inspection by: STEVE HEDRICK date 11-14-97

Installed by: A-1 BACKHOE

~~Certificate of Completion~~ by: date

Operation Permit by: STEVE HEDRICK date 11-26-97

HEALTH DEPT COPY: WHITE INSPECTION COPY (FINAL): GREEN OWNER COPY (FINAL): YELLOW INSPECTION COPY (INITIAL): PINK OWNER COPY (INITIAL): GOLD

1662 0 0