KACHEL L. ARRINGTON

1000

IREDELL COUNTY HEALTH DEPARTMENT

STATESVILLE 704-878-5305 MOORESVILLE 704-664-5281

IMPROVEMENT PERMIT / CERTIFICATE OF COMPLETION / OPERATION PERMIT / EXISTING SYSTEM INSPECTION

PROPERTY DESCRIPTION NO. 25885 DATE 1-16-97

OWNER OR CONTRACTOR RACHEL ARRINGTON TAX MAP NO. 14P-A-7 (PIN# 4821813726) Watershed: ☐ Yes ☒ No

ADDRESS 831 MYER MILL ROAD PHONE: Business Home 592-7464

LOCATION NC 115 N, TR BRUCE FARM, TL REX LANE, BEAR RIGHT, 2ND MH on R OLIN, NC 28660

SUBDIVISION BLOCK / SECTION LOT LOT AREA 30.35 SITE CLASS. PS DESIGN FLOW 240 L.T.A.R. 0.30 GPD/FT²

Septic Tank: 1000 Gallons; STB 1012 Date 12-3-96

Pump Tank: Gallons; PT Date

Pump Make: Model Serial No.

Nitrification Field: No. Fields 1 Square Feet 810 Linear Feet 270

No. Lines THREE Trench Width 36" Max Trench Bottom Depth 36 Gravel Depth 12"

☒ New System ☐ Repair System Type: I, II, III, IV, V, VI

System Description: CONVENTIONAL GRAVITY

Repair System Description: CHAMBERED GRAVITY

Maintenance Agreement Required: ☐ Yes ☒ No

☐ House/Mod. Home ☑ Mobile Home ☐ Business ☐ Other

No. Bedrooms 3 No. Bathrooms 2 No. Employees


☐ Slab ☑ Crawl Space ☐ Basement w/plumbing ☐ Basement wo/plumbing

Water Supply: ☐ Individual ☐ Community ☐ Public


Comments:

Comments:

INITIAL SITE SKETCH

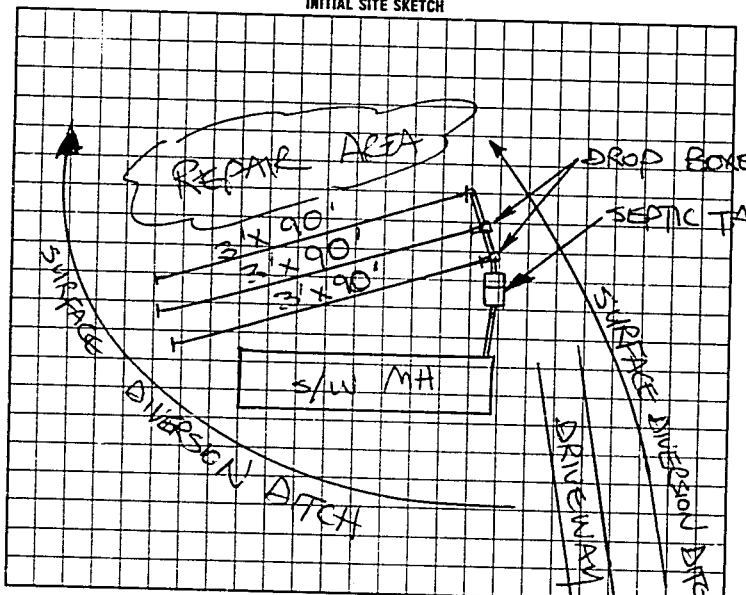

AS BUILT SKETCH

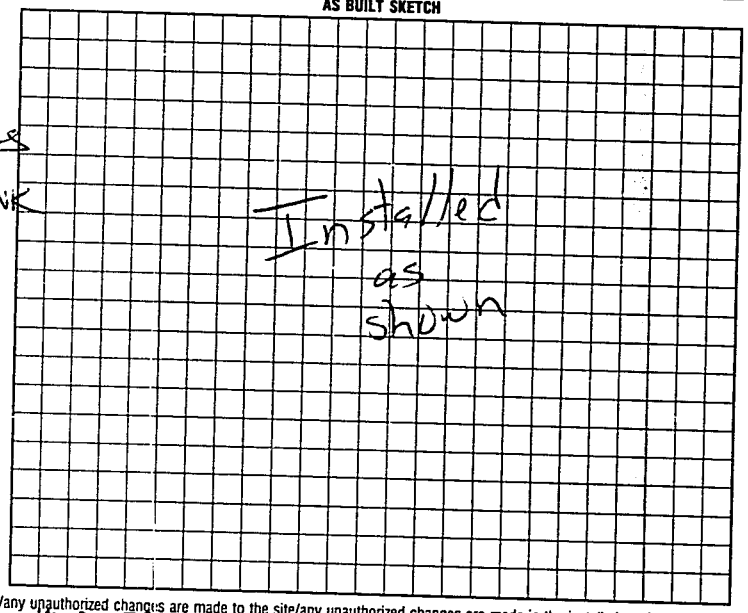

I understand that this permit can be suspended or revoked if any false information is supplied toward securing the permit/any unauthorized changes are made to the site/any unauthorized changes are made in the installation of the system. Improvement Permit is valid for 60 months from date of issuance. AUTH. TO CONST. IS VALID FOR 60 MONTHS

Signed: Steven N Arrington

Improvement Permit by: STEVE HEDRICK date 1-16-97

AUTH. TO CONST. Existing System Inspection by: STEVE HEDRICK date 1-16-97

Installed by: A-1 Backhoe

Certificate of Completion by:

Operation Permit by: Mary C. O. A. date 3-13-97

HEALTH DEPT. COPY WHITE INSPECTION COPY (FINAL) GREEN OWNER COPY (FINAL) YELLOW INSPECTION COPY (INITIAL) PINK OWNER COPY (INITIAL) GOLD