IREDELL COUNTY HEALTH DEPARTMENT

STATESVILLE 704-878-5305 MOORESVILLE 704-664-5281

057425

IMPROVEMENT PERMIT / CERTIFICATE OF COMPLETION / OPERATION PERMIT / EXISTING SYSTEM INSPECTION

PROPERTY DESCRIPTION NO. 23281 DATE 3-26-96 TAX MAP NO. 14P-A-7 Watershed: ☐ Yes ☑ No

OWNER OR CONTRACTOR RACHEL ARRINGTON PHONE Business Home 592-7464

ADDRESS 831 MYERS MILL ROAD OLIN, NC 28660

LOCATION NC 115 N, TR BRUCE FARM ROAD, TL REX LANE, BEAR (L) AT END

SUBDIVISION BLOCK / SECTION LOT LOT AREA AMPLE SITE CLASS PS DESIGN FLOW 1240 L.T.A.R. 0.25 GPD/FT²

Septic Tank: 1000 Gallons: STB 794 Date 2-15-96
Pump Tank Gallons: PT Date
Pump Make Model Serial No
Nitrification Field No Fields 1 Square Feet 960 Linear Feet 320
No Lines 4 Trench Width 36" Max Trench Bottom Depth 18-24" Gravel Depth 12"

☑ New System ☐ Repair System Type: I II III IV V
System Description: CONVENTIONAL GRAVITY
Repair System Description: CONV. GRAVITY
Maintenance Agreement Required Yes ☑ No
Slab ☐ Crawl Space Basement w/plumbing Basement wo/plumbing


☑ House/Mod Home No Bedrooms 2
☐ Mobile Home No Bathrooms 1
Business No Employees
Other

Water Supply: ☑ Individual ☐ Community ☐ Public WELL

Comments: ① KEEP SYSTEM MINIMUM 5' FROM MH, TO 7' FROM WELL ② INSTALL LINES ON CONTOUR, NO DEEPER THAN (24"), 9' MINIMUM APART ON CENTERS.

Comments:

INITIAL SITE SKETCH

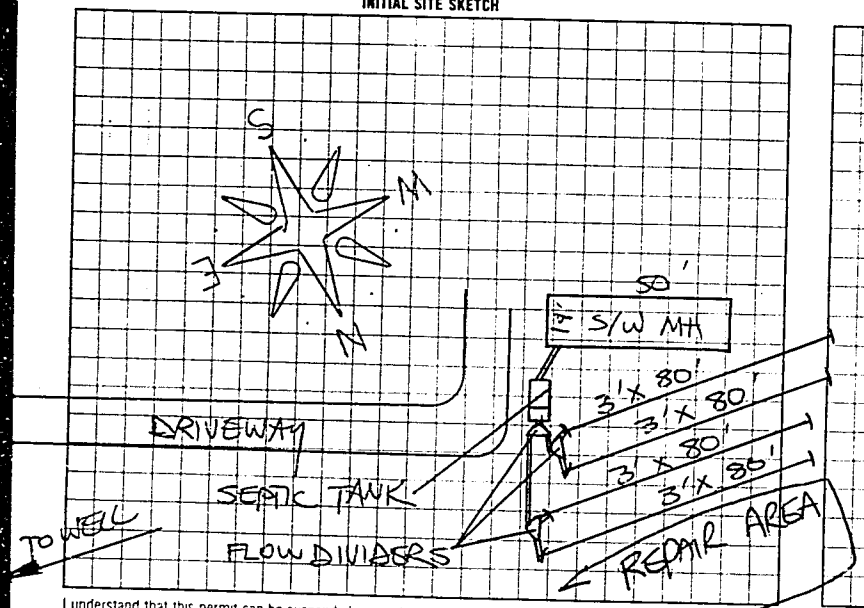

AS BUILT SKETCH

SYSTEM INSTALLED ACCORDING TO INITAL SITE SKETCH

I understand that this permit can be suspended or revoked if any false information is supplied toward securing the permit/any unauthorized changes are made to the site/any unauthorized changes are made in the installation of the system

AUTHORIZATION TO CONSTRUCT IS VALID FIVE (5) YEARS FROM DATE OF ISSUANCE. IMPROVEMENT PERMIT HAS NO EXPIRATION DATE.

Signed X J.H. Arrington

Improvement Permit by: STEVE HEDRICK date 3-26-96 Installed by A-1 BACKHOE

AUTHORIZATION TO CONSTRUCT

Existing System Inspection by STEVE HEDRICK date 3-26-96 Certificate of Completion by date

Operation Permit by STEVE HEDRICK date 4-11-96

APPLICANT COPY WHITE INSPECTION COPY (FINAL) GREEN OWNER COPY (FINAL) YELLOW INSPECTION COPY (INITIAL) PINK

8 6 2 6 0 0